


G-3566
G-4668
38733
38734

T. 4 N. R. 29 E. W. M.

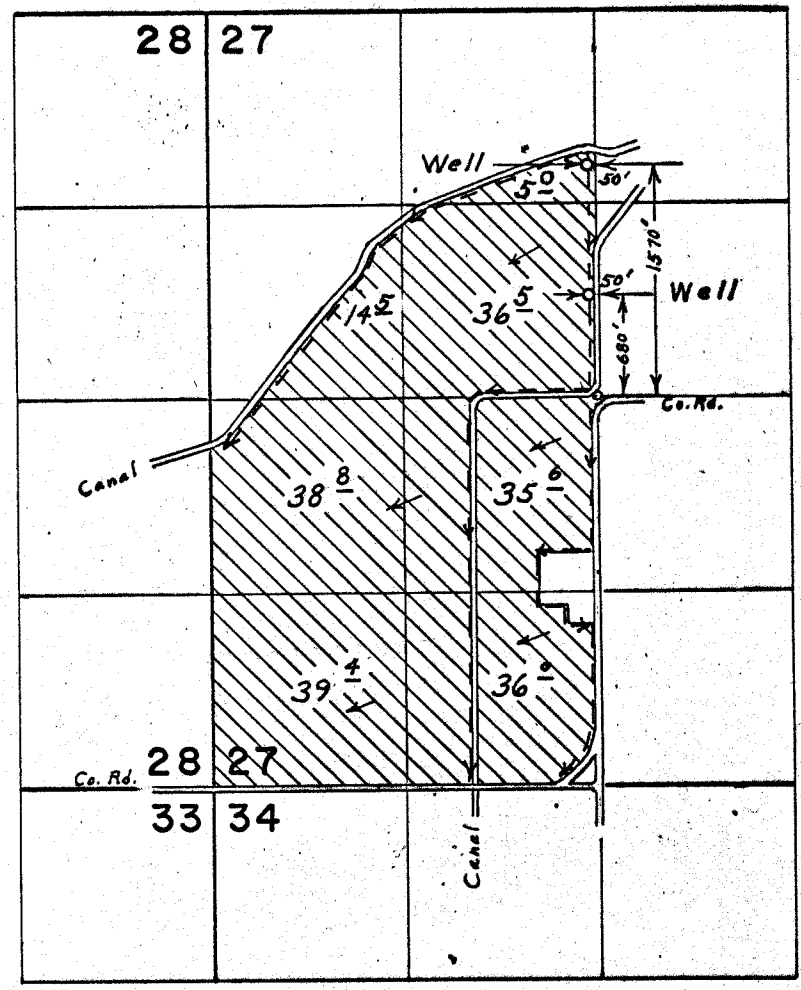

FINAL PROOF SURVEY UNDER

Application No. G-3781 Permit No. G-3566
G-4946 G-4668

IN NAME OF
DON MILLS

Surveyed Aug. 27, 1971, by L. E. Gould