


T. 4 N., R. 29 E., W. M.

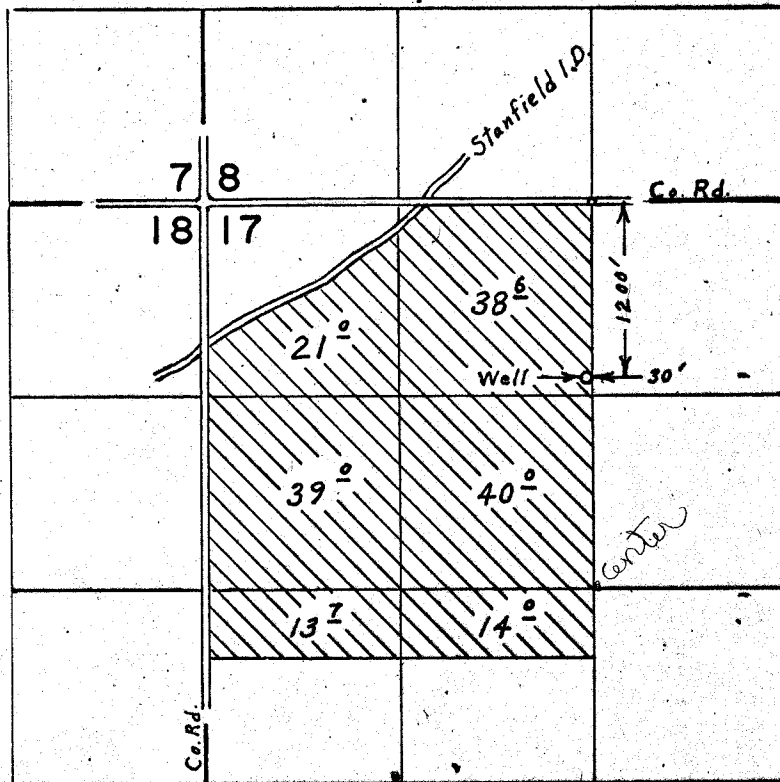

FINAL PROOF SURVEY UNDER

Application No. G-4009. Permit No. G-3761.
IN NAME OF

M. L. KOESTER

Surveyed Aug. 27, 1971, by J. E. Gould.