


G-3831
39736

T.6 N., R.35 E. W.M.
SE 1/4, SEC. 15

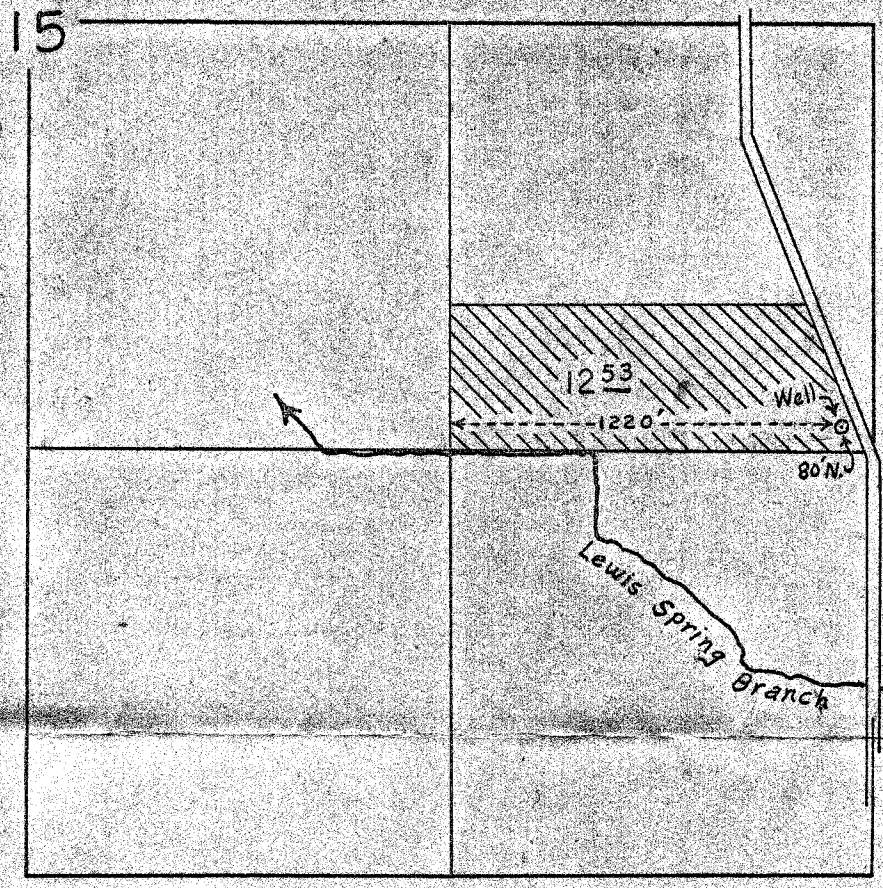

1" = 600'

MAP TO ACCOMPANY APPLICATION
TO APPROPRIATE WATER
PETE KESSLER

Application No. G-4076
Permit No. G-3831