


G-3966
39737 7

T. 4 N. R. 27 & 28 E. W. M.

CANCELLED
145 P83

See T-6415

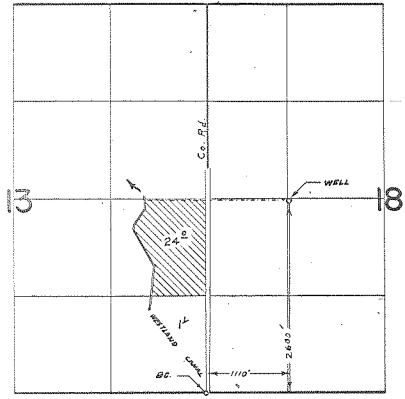

FINAL PROOF SURVEY UNDER

Application No. G-4201... Permit No. G-3966.
 IN NAME OF
THOMAS E. HUDDLESTON.....
 Surveyed AUG. 24, 1971., by L. E. GOULD.....