


G-4100  
38738.7

RECEIVED  
APR 28 1968  
STATE ENGINEER  
OREGON

T.6N., R.35E.W.M.  
SW1/4, Sec. 28

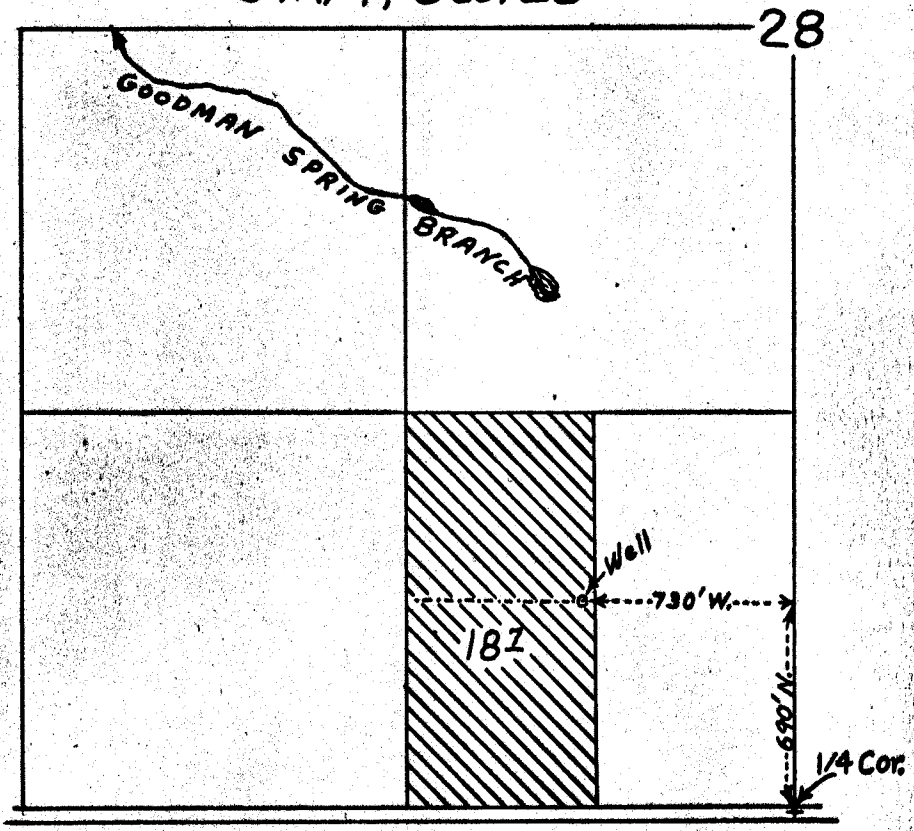

1" = 660'

MAP TO ACCOMPANY APPLICATION  
TO APPROPRIATE WATER  
SOURCE - A WELL  
MABEL KNOSP

Application No. G-4343  
Permit No. G-4100