


T.3S.R.12E.W.M.

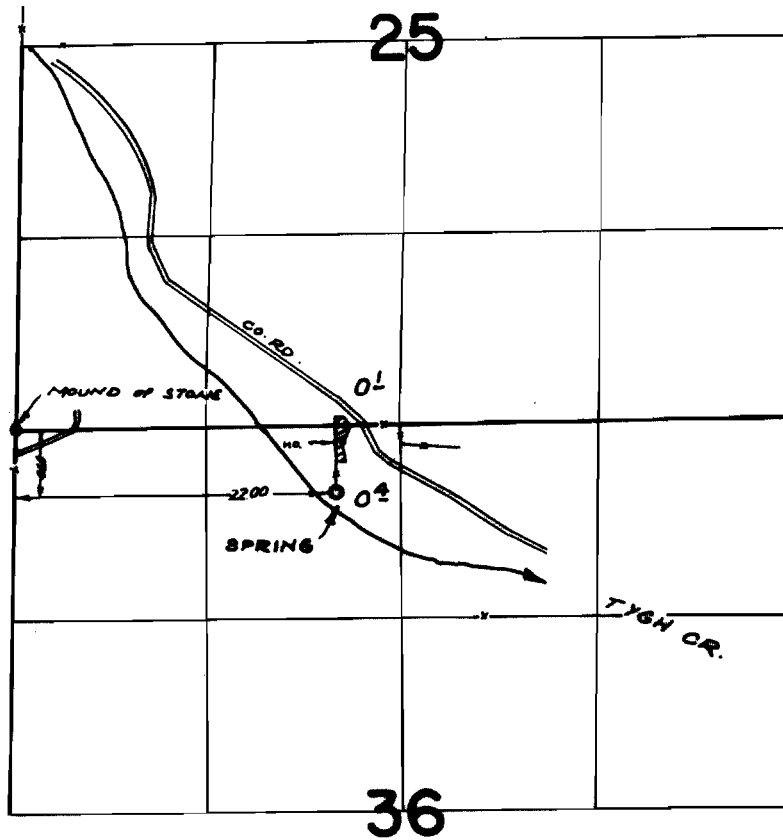

FINAL PROOF SURVEY
UNDER

Application No. 15809 Permit No. 34184
IN NAME OF

ROBERT A. JOHNSON

Surveyed Nov. 2 1971, by R. MURKEN.