


T. I. S. R. 3 W. W. M.

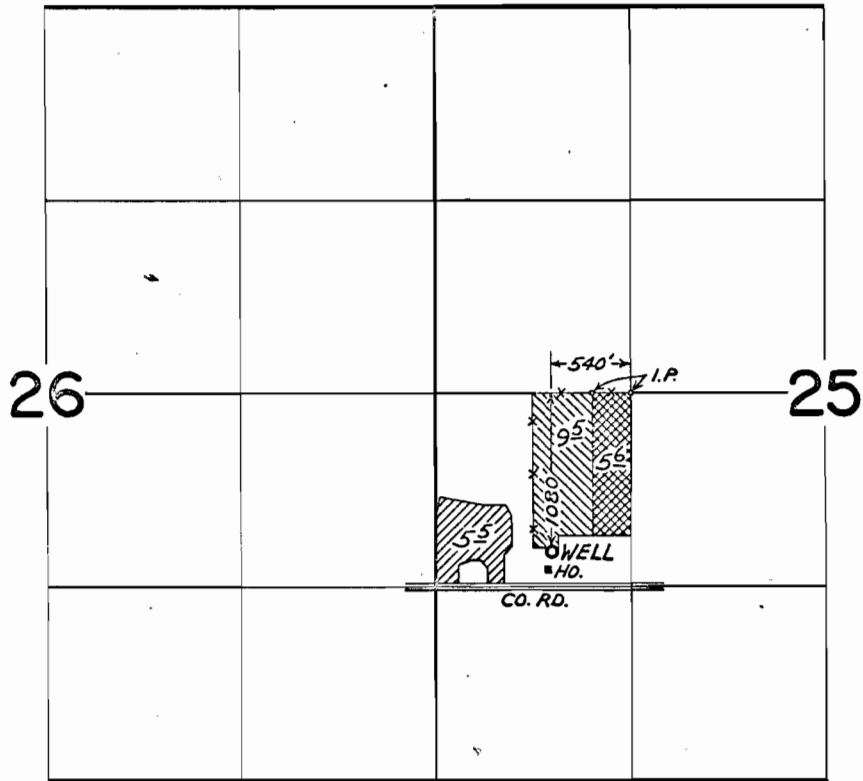

FINAL PROOF SURVEY UNDER

G-3266

G-3063

G-4155

G-3907

Application No. ~~G-4879~~ Permit No. ~~G-4594~~

IN NAME OF

IRA BARBY

Surveyed SEPT. 16, 1971, by GREG. BACA

