


# T. 1 S. R. 3 W. W. M.

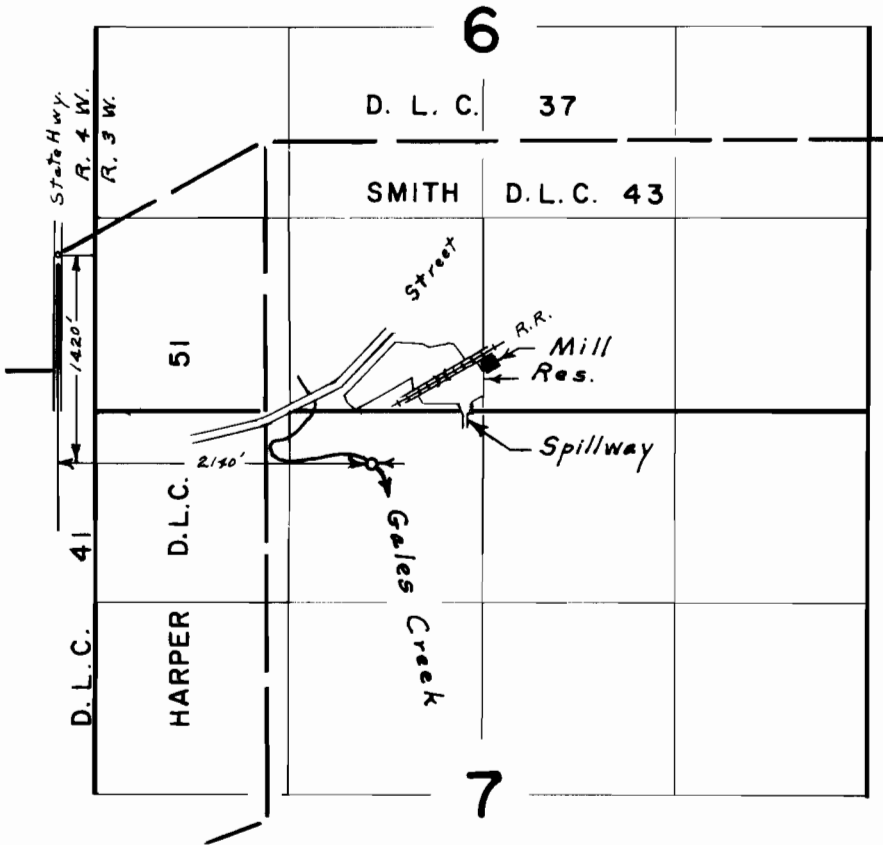

## FINAL PROOF SURVEY UNDER

Application No. R-44327 Permit No. R-5127  
IN NAME OF

FOREST GROVE LUMBER CO.

Surveyed April 22 1971, by L. E. Gould