


T. 1 S. R. 3 W. W. M.

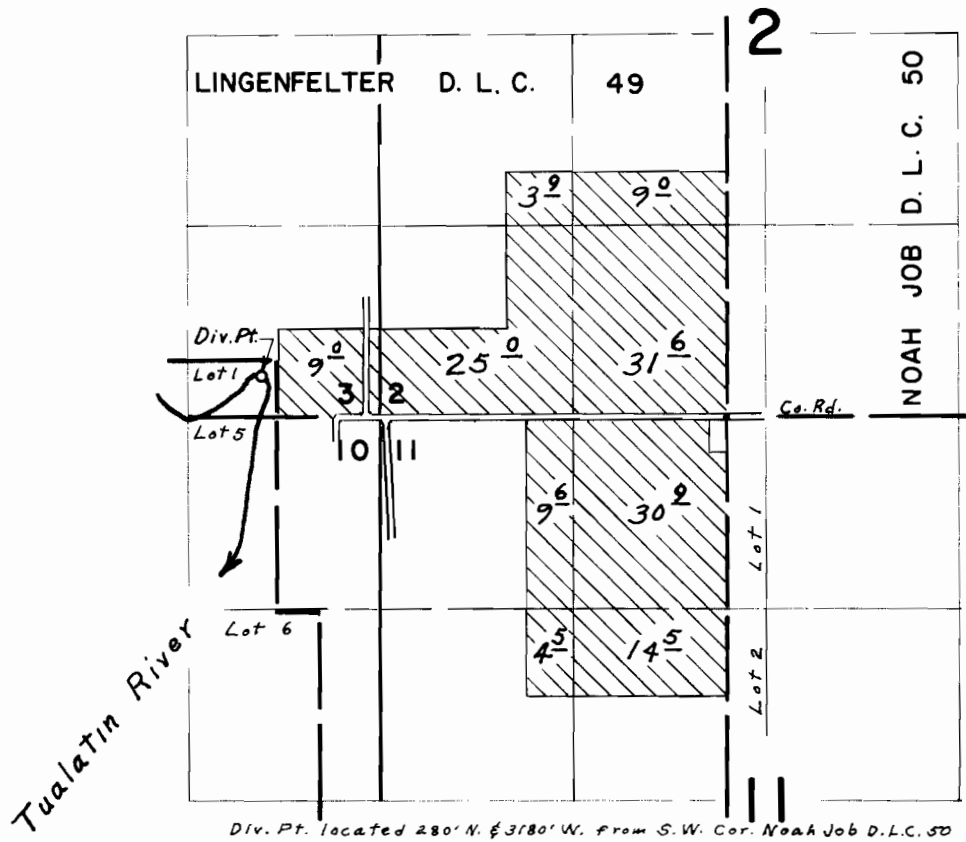

FINAL PROOF SURVEY UNDER

Application No. 41929 Permit No. 30877
IN NAME OF

DANIEL F. HERING

Surveyed April 20, 1971, by L. E. Gould