T.1N.R.4W.W.M.

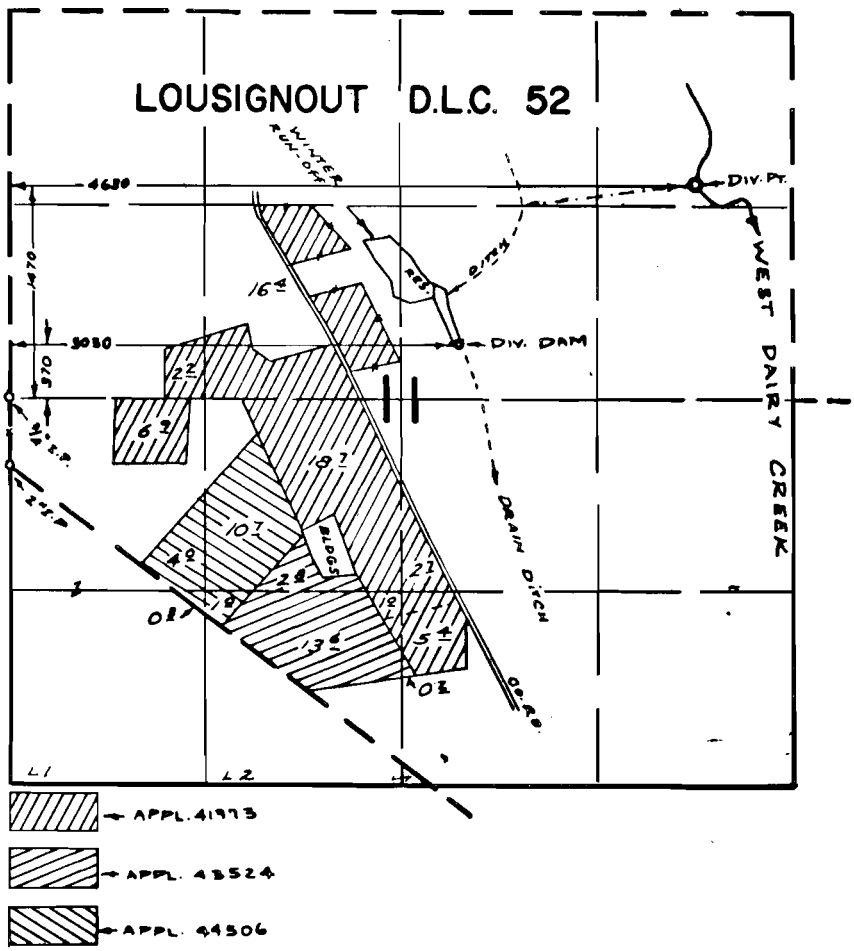

FINAL PROOF SURVEY

UNDER

Application No. 41973 R-41972 43524 44506 Permit No. 31398 R-4775 32562 33308

IN NAME OF

VERNON E. LYDA

Surveyed January, 1971, by R. MUCKEN