


ICE & STATE ENGINEER
REGISTERED
APR 4 1918
SALEM, OREGON

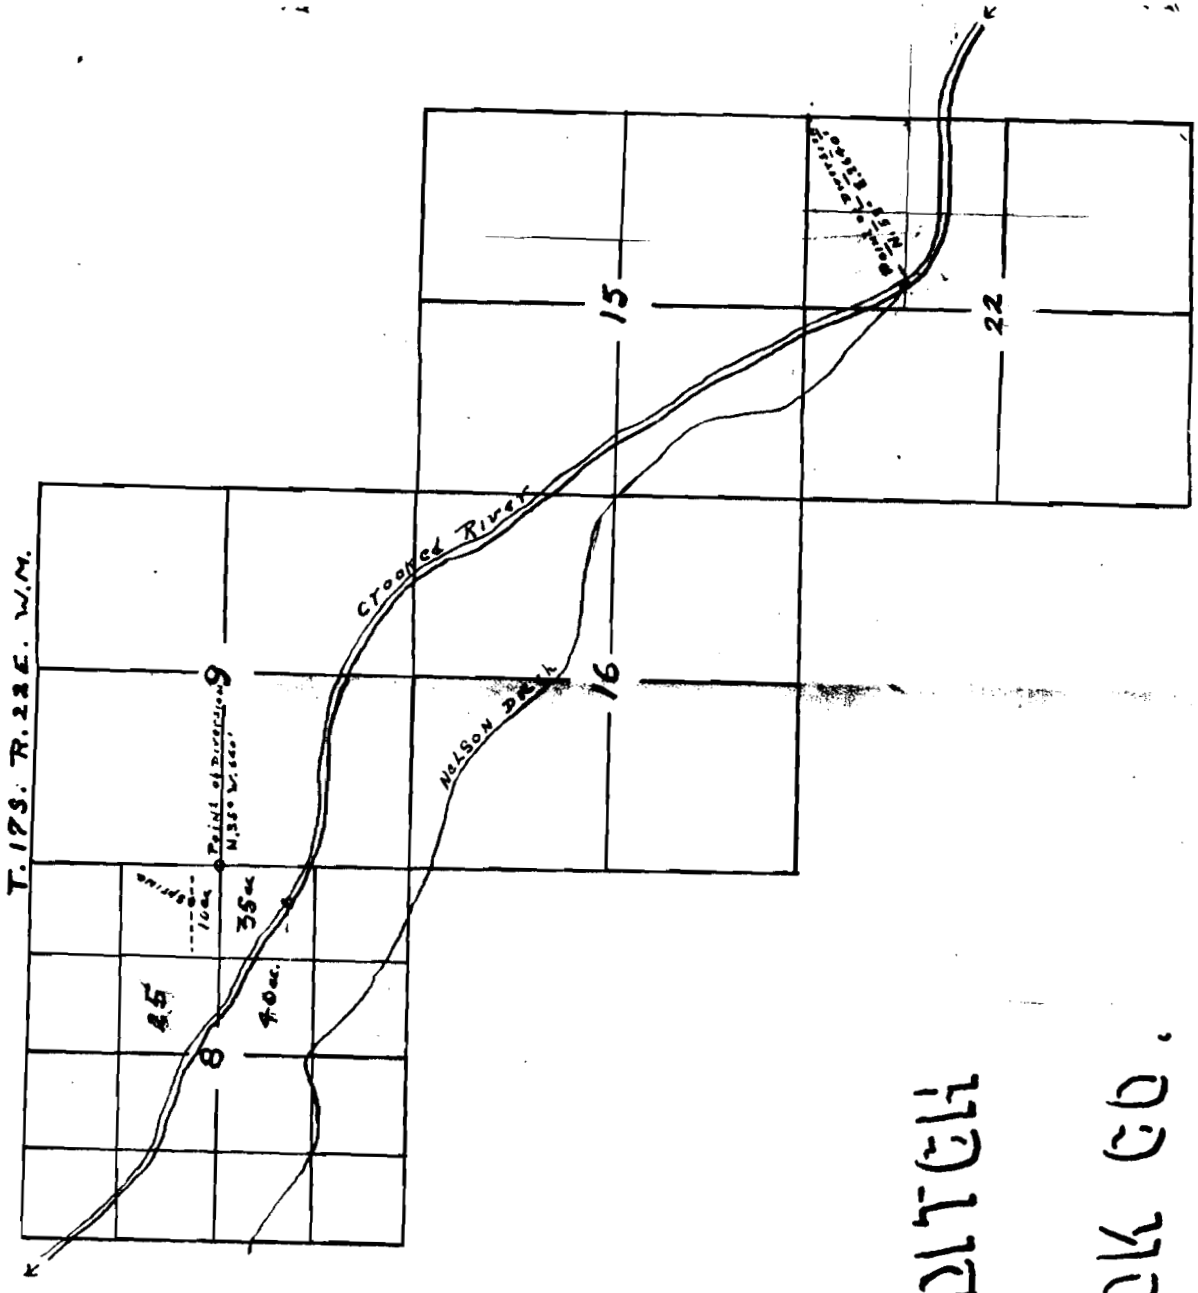

NELSON DITCH
CROOK CO.

Application No. 6054
Perm. No. 3768

60024