


# T. 1N.R. 4W.W.M.

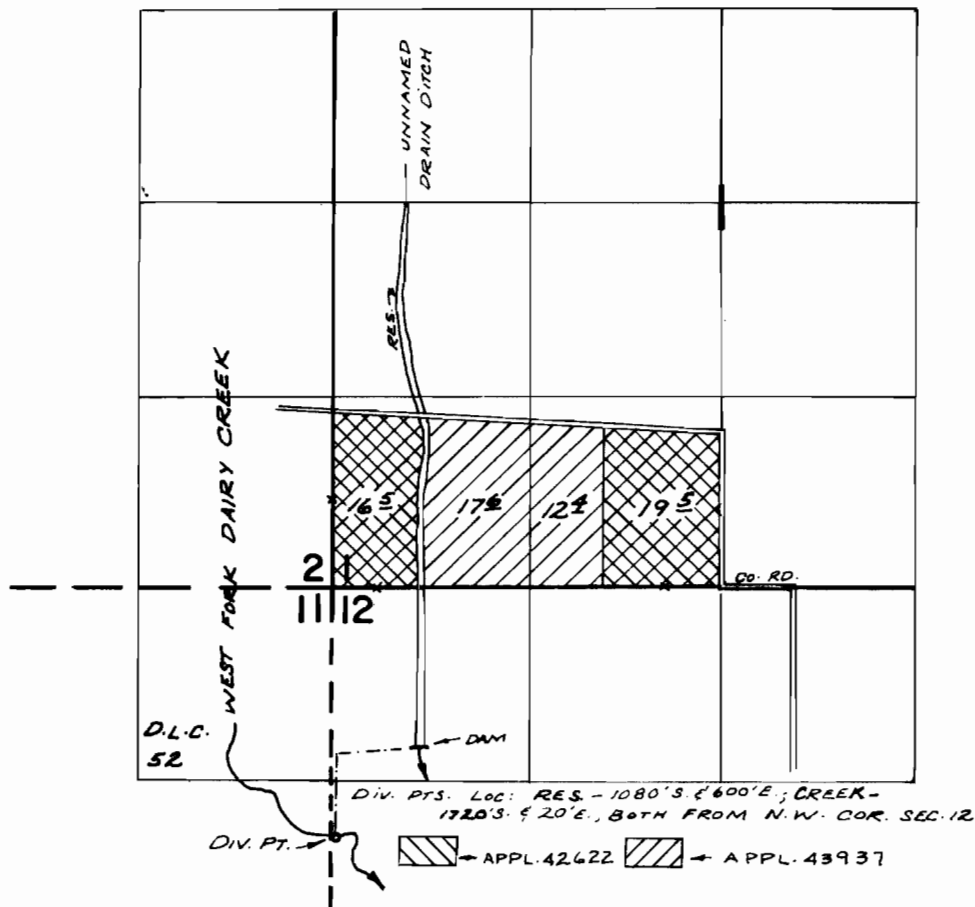

## FINAL PROOF SURVEY UNDER

Application No. <sup>42622</sup>~~43936~~ Permit No. <sup>31838</sup>~~32830~~  
~~43937~~ R-5055

IN NAME OF

ANTHONY P. HERB

Surveyed JUNE 17, 1971, by R. MUCKENY