


T. 1N. R. 4W. W.M.

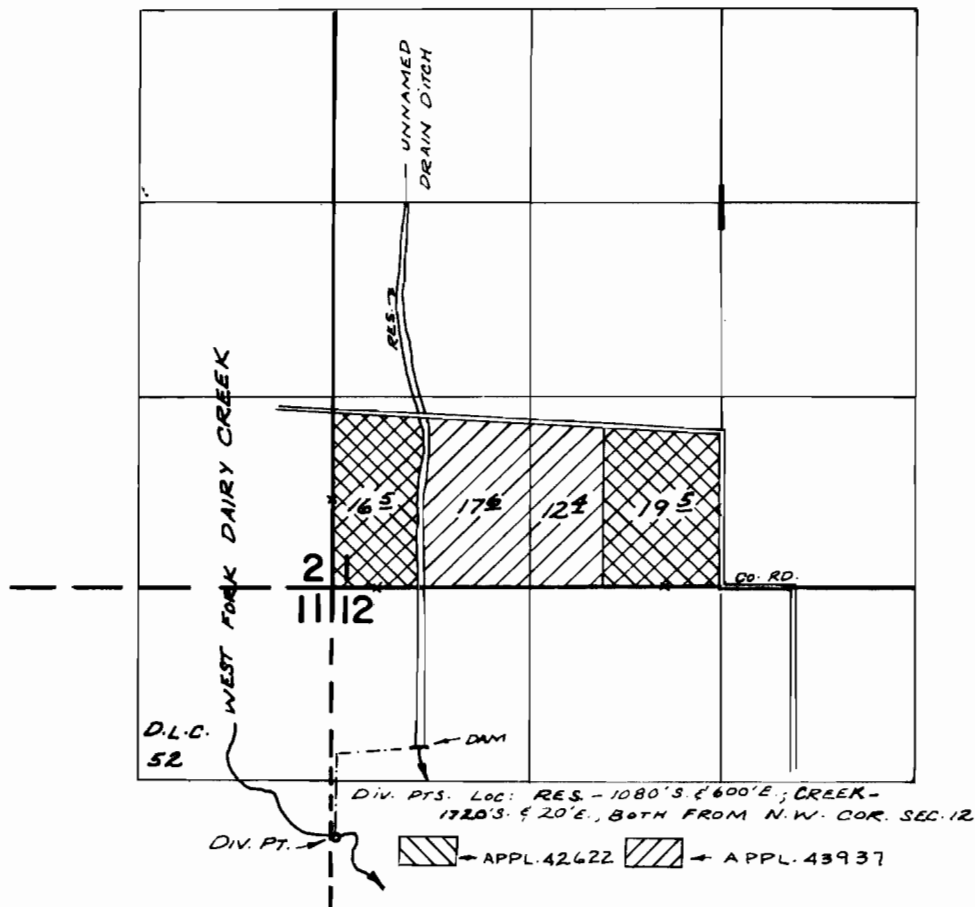

FINAL PROOF SURVEY UNDER

Application No. ⁴²⁶²² ~~R-48936~~ ⁴³⁹³⁷ Permit No. ³¹⁸³⁸ ~~R-5055~~ ³²⁸³⁰

IN NAME OF

ANTHONY P. HERB

Surveyed JUNE 17, 1971, by R. MUCKEY