


T. 1N.R. 4W.W.M.

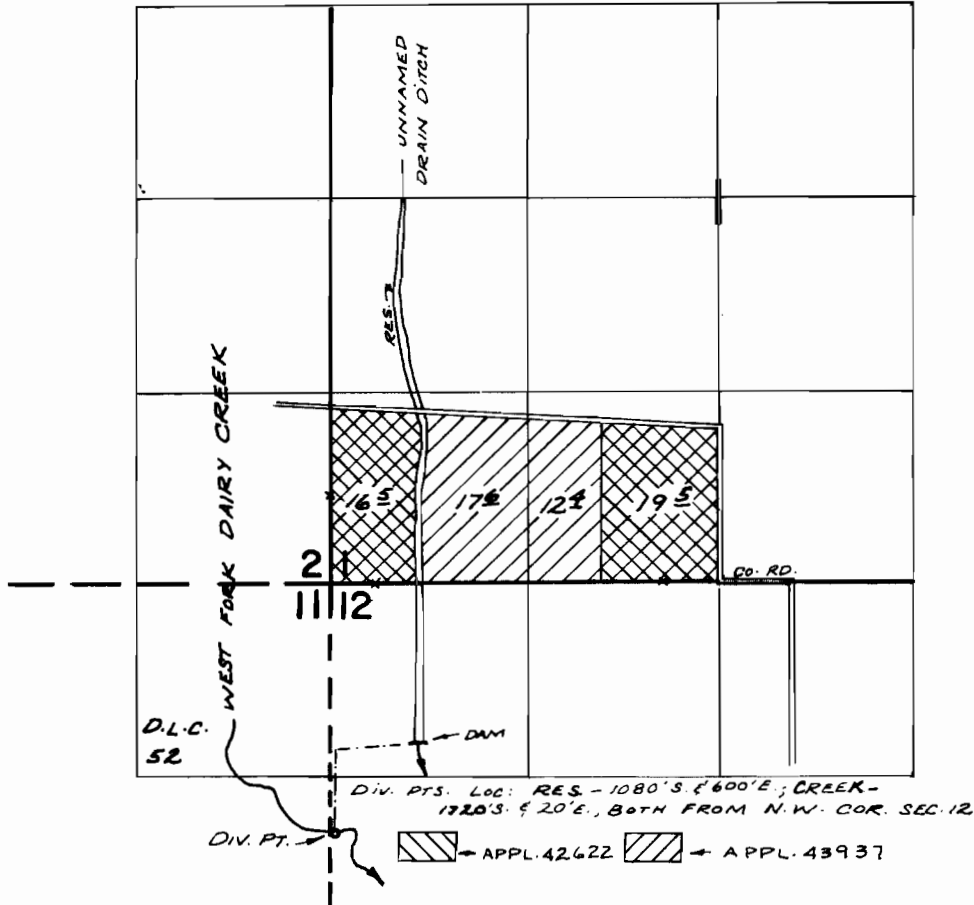

FINAL PROOF SURVEY UNDER

Application No. ⁴²⁶²² ~~43936~~ ³¹⁸³⁸ Permit No. ^{R-5055} ~~32830~~
IN NAME OF

ANTHONY P. HERB

Surveyed JUNE 17, 1971, by R. MUCKEN.