


T. 1 N. R. 4 W. W. M.

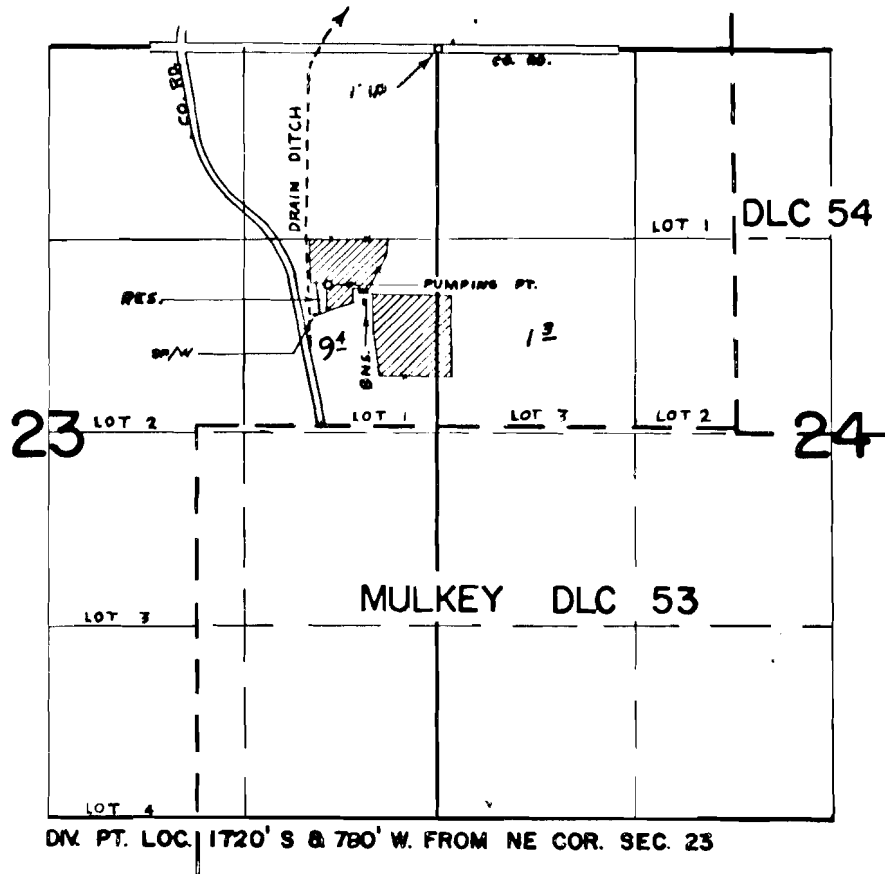

FINAL PROOF SURVEY
UNDER

R-42987 R-4885
Application No. 42988 Permit No. 32118
IN NAME OF

LOUIS JUNCKER

Surveyed JUNE 16, 1971, by R. MUCKEN.....