


T. 1 N. R. 4 W. W. M.

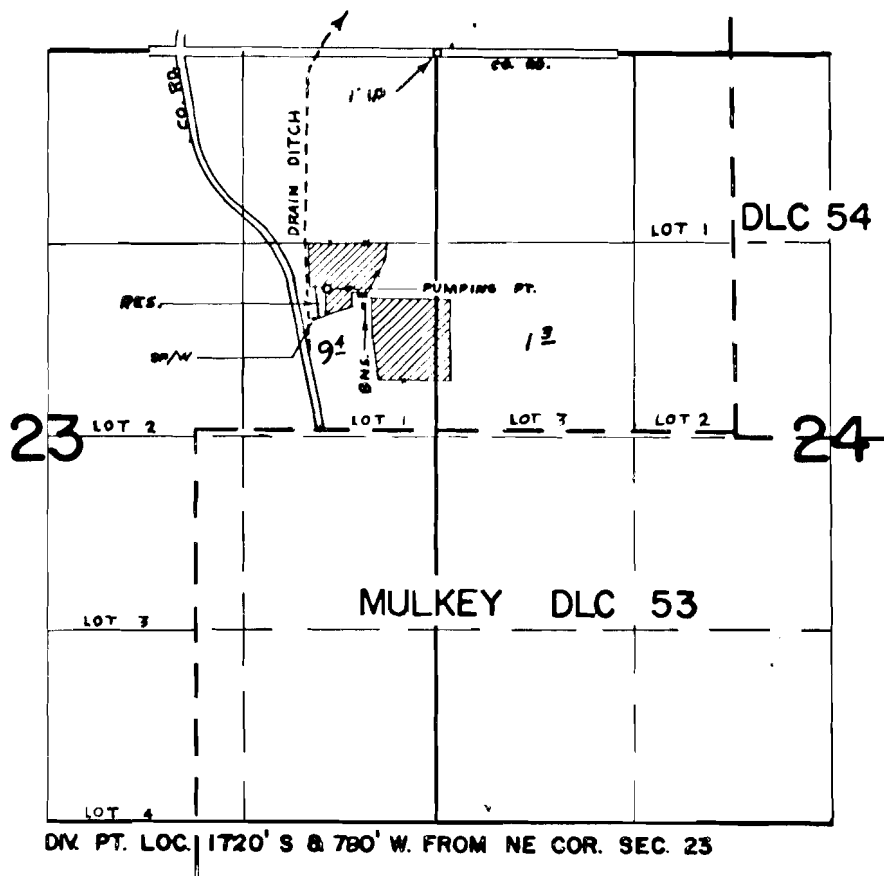

FINAL PROOF SURVEY UNDER

R-42987 R-4885
 Application No. 42988 Permit No. 32118
 IN NAME OF

LOUIS JUNCKER

Surveyed JUNE 16, 1971, by R. MUCKEN