


31688
38765 6

T.8S.R.24&25E.W.M.

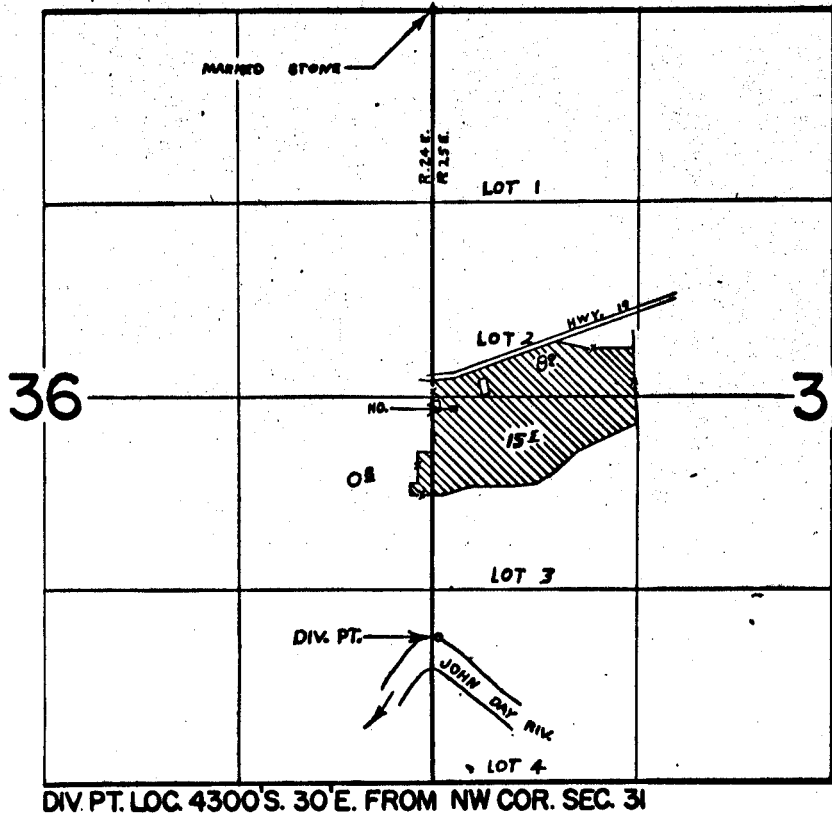

FINAL PROOF SURVEY UNDER

Application No. 42352 Permit No. 31688
IN NAME OF

JAKE P. NASH

Surveyed JULY 23, 1971, by R. MUCKEN