


T. 2 S. R. 3 W. W. M.

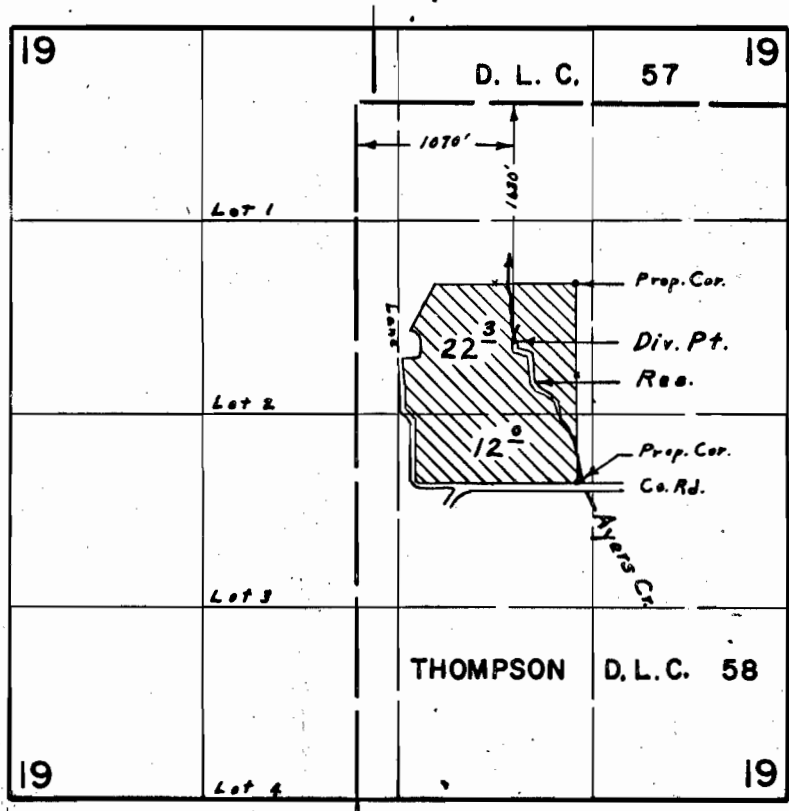

FINAL PROOF SURVEY UNDER

39756 29568
R-41818 R- 4684
Application No. 41819 Permit No. 31044
IN NAME OF

EUGENE OBERG

Surveyed April 27, 1971, by L. E. Gould