


# T. 2 S. R. 4 W. W. M.

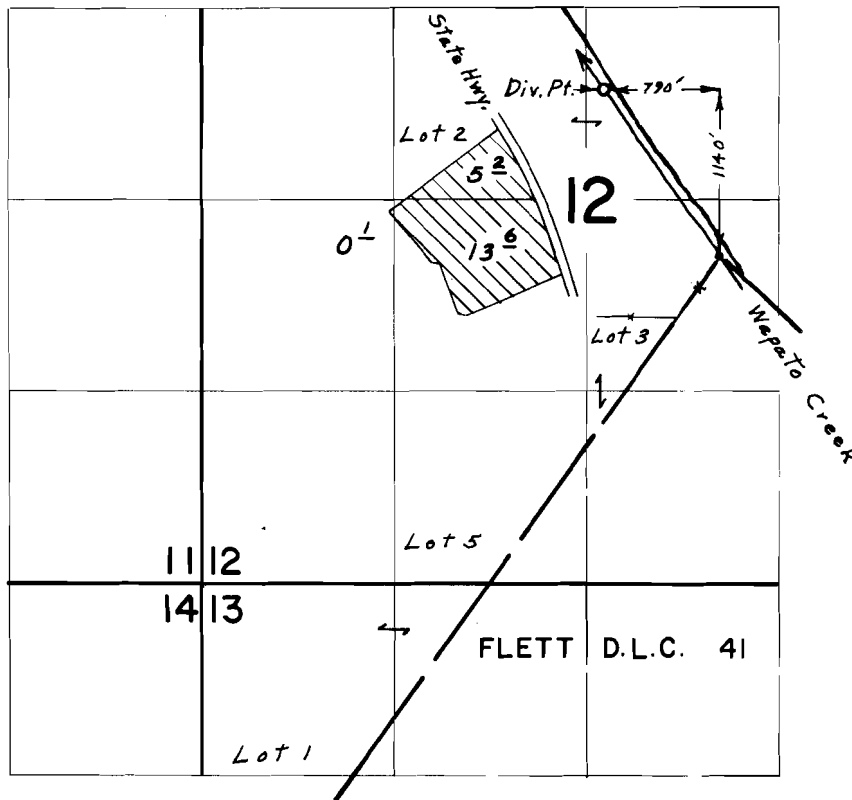

## FINAL PROOF SURVEY UNDER

Application No. 46209 Permit No. 34525  
IN NAME OF

ROBERT PHILLIPS

Surveyed April 29, 1971, by L. E. Gould