


Application No. 47760  
Permit No. 35773

T. 10 S. R. 4 W. W. M.

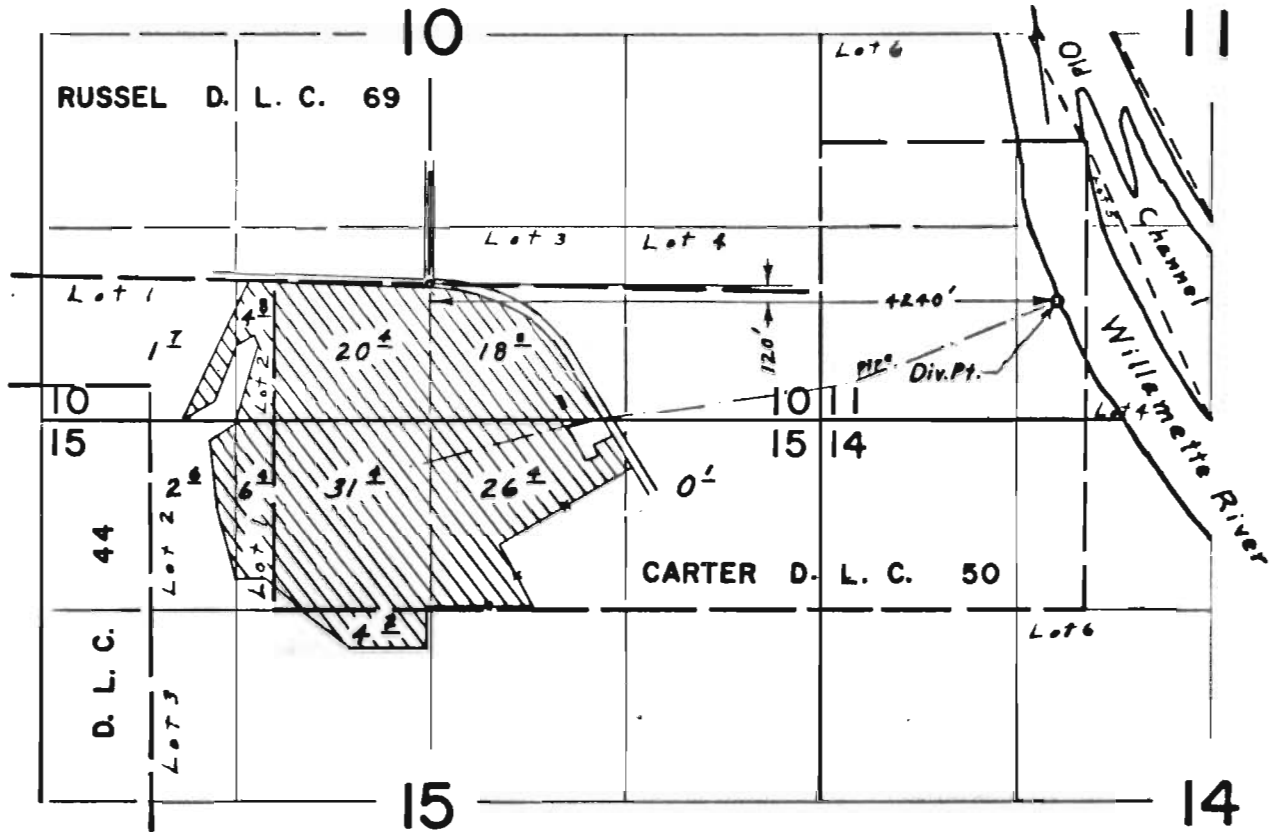

**FINAL PROOF SURVEY**  
UNDER

Application No. 43272. Permit No. 32744.  
IN NAME OF

**KENNETH HOLMES**

Surveyed May 6, 1969, by L. E. Gould.