


T. 2 S. R. 2 E. W. M.

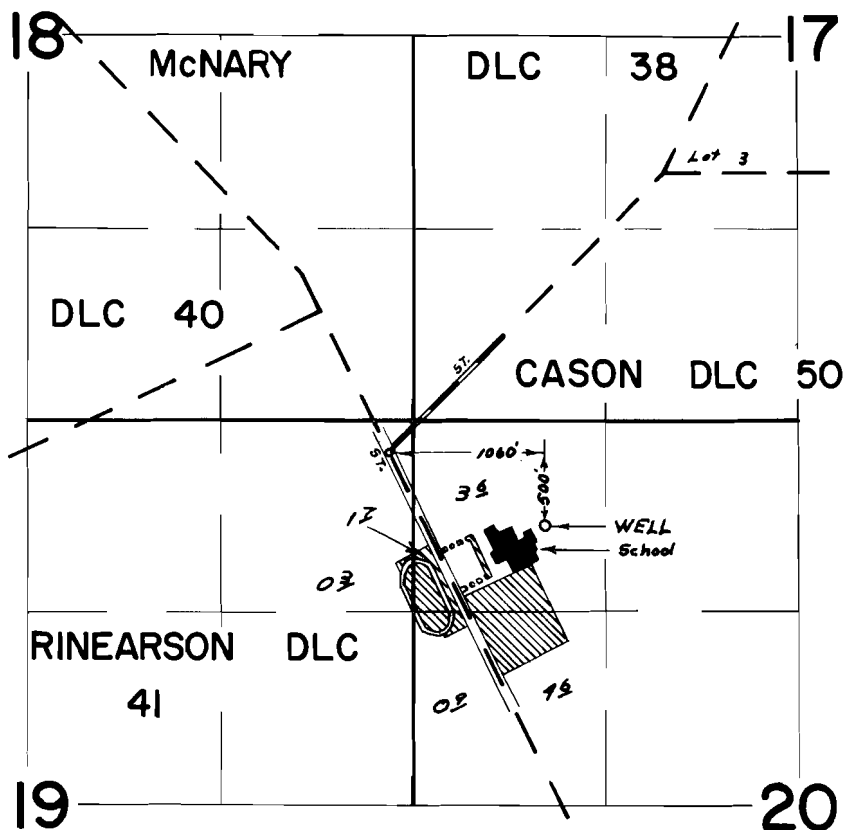

FINAL PROOF SURVEY
UNDER

Application No. G-4519 Permit No. G-4259
IN NAME OF

GLADSTONE SCHOOL DISTRICT 115

Surveyed OCT. 28, 1971, by R. MUCKEN