


# T.2S.R.3E.W.M.

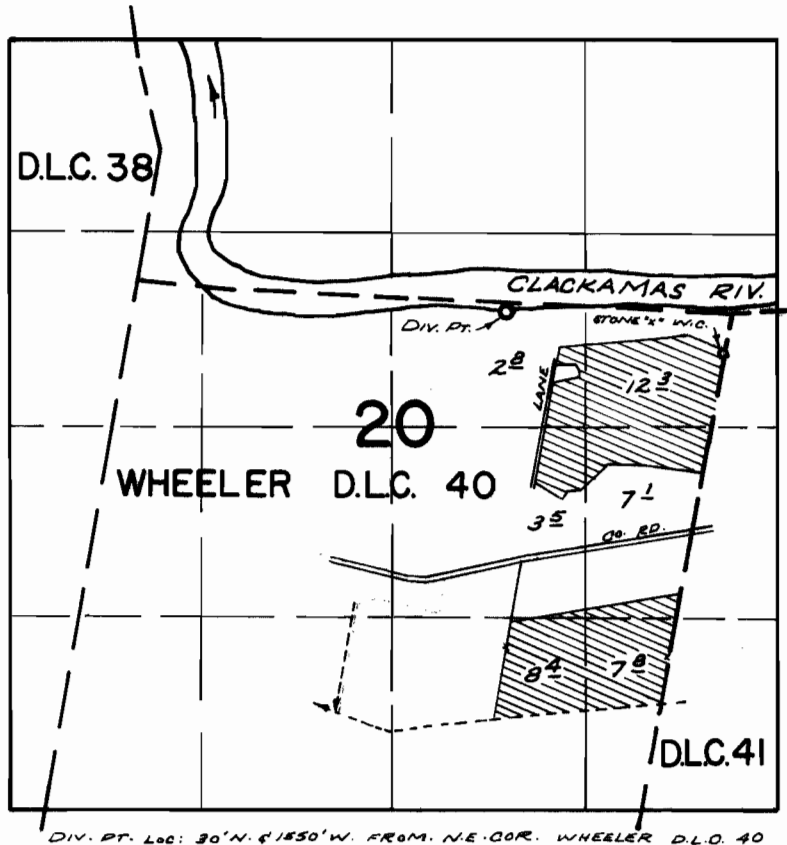

## FINAL PROOF SURVEY UNDER

Application No. 32772 Permit No. 28846  
IN NAME OF

ELMORE MOSTUL

Surveyed Nov. 17 1971, by R. MURKIN.