


T. 2 S. R. 3 E. W. M.

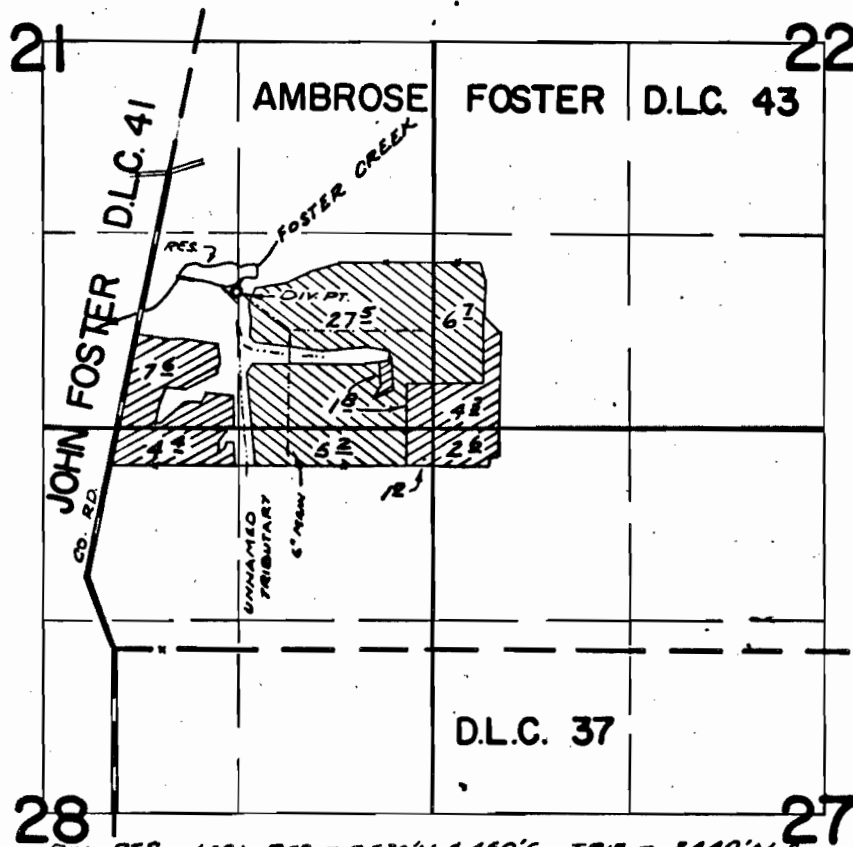

DIV. PTS. LOC: RES. - 2530'N. & 450'E, TRIB. - 2440'N. & 830'E, BOTH FROM S.W. COR. D.L.C. 43



- APPL. 37839



- APPL. 42856

FINAL PROOF SURVEY UNDER

R-37838 R-4574
37839 30429
Application No. 42856 Permit No. 32030
IN NAME OF

ELMORE MOSTUL

Surveyed Nov. 16 1971, by R. MUCKEN