


T. 2 S. R. 3 E. W. M.

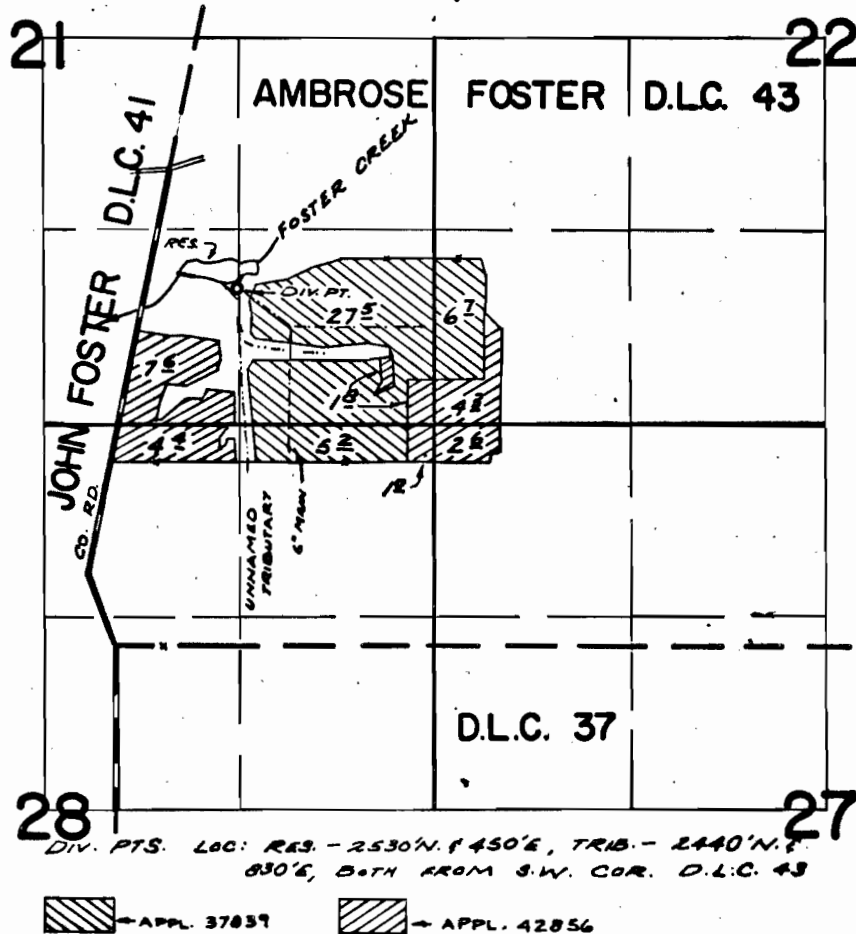

FINAL PROOF SURVEY UNDER

R-37838 R-4574
 37839 30429
 Application No. 42856 Permit No. 32030
 IN NAME OF

ELMORE MOSTUL

Surveyed Nov. 16 1971, by R. MUCKEN