


T. 2 S. R. 3 E. W. M.

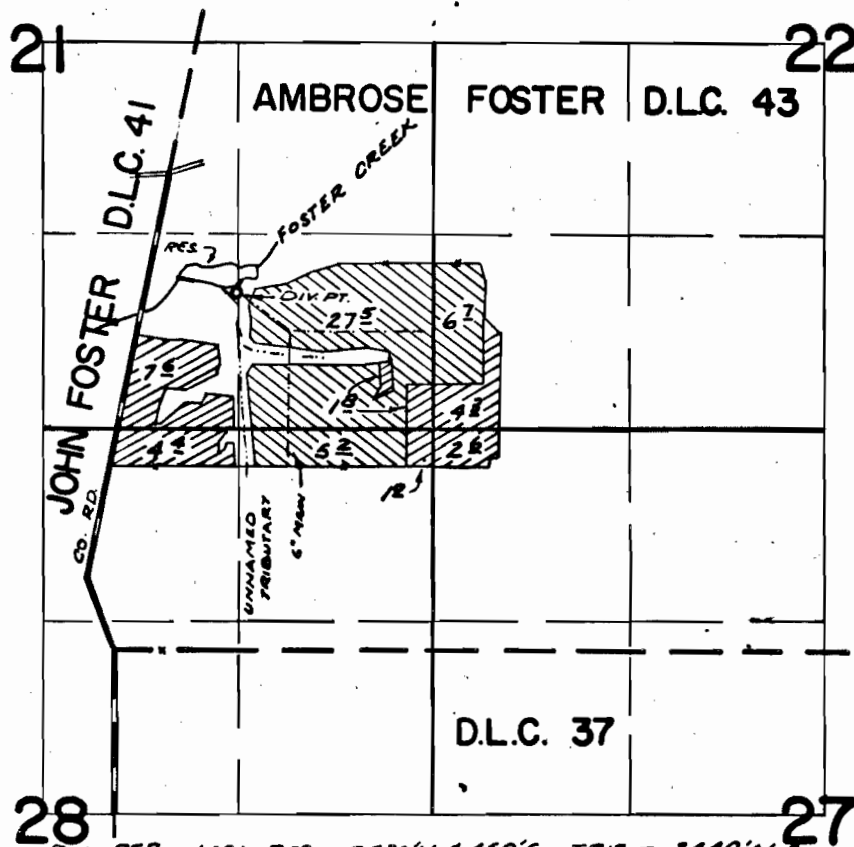

DIV. PTS. LOC: REG. - 2530'N. & 450'E, TRIB. - 2440'N. &
830'E, BOTH FROM S.W. COR. D.L.C. 43



←APPL. 37059



APPL. 42856

FINAL PROOF SURVEY

UNDER

R-37838
37839

R-4574
30429

Application No. 12056 Permit No. 32090
IN NAME OF

ELMORE MOSTUL

Surveyed Nov 16 1971, by R. MUGKEN