


# T.4S.R.1&2E.W.M.

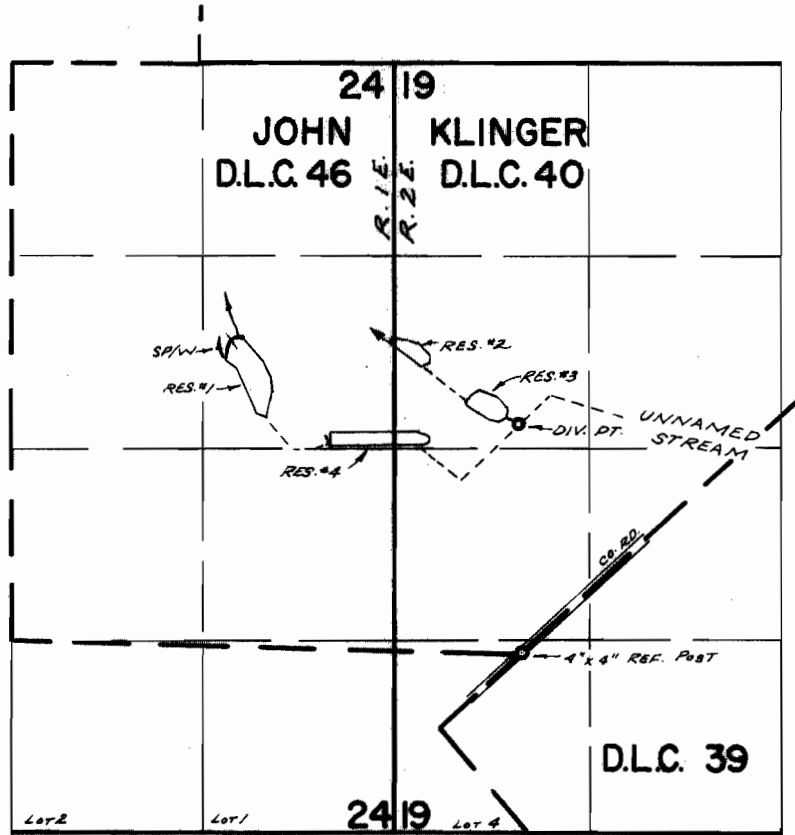

DIV. PTS. LOC: \*1- 2170'N. & 1950'W.; \*2- 2130'N. & 910'W.; \*3- 1570'N. & 20'W.; \*4- 1430'N. & 1320'W., ALL FROM S.E. COR. D.L.C. 40

## FINAL PROOF SURVEY UNDER

R-44907                      R-5303  
 Application No. 44908    Permit No. 33574  
 IN NAME OF

WILLARD G. DEARDORFF

SEPT. 21, 1970                      L.E. GOULD  
 Surveyed APRIL 26, 1971, by R. MUCKEN