T.4 S.R.1 & 2 E.W.M.

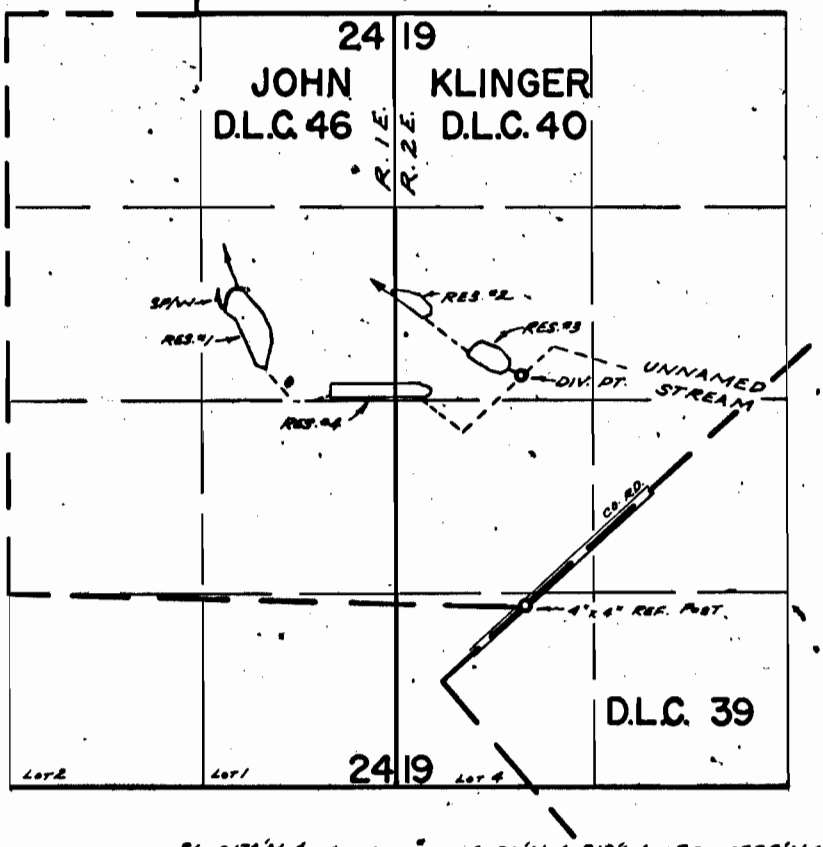

DIV. PTS. LOC: #1 - 2170'N. & 1950'W.; #2 - 2130'N. & 910'W.; #3 - 1570'N. & 20'W.; #4 - 1430'N. & 1320'W., ALL FROM S.E. COR. D.L.C. 40

FINAL PROOF SURVEY

UNDER

Application No. R-44907 44908 Permit No. R-5303 33574

IN NAME OF

WILLARD G. DEARDORFF

Surveyed SEPT. 21, 1970 APRIL 26, 1971, by L.E. GOULD R. MUNKEN

1970-W