



T.16 S.R.10E.W.M.

C 38807

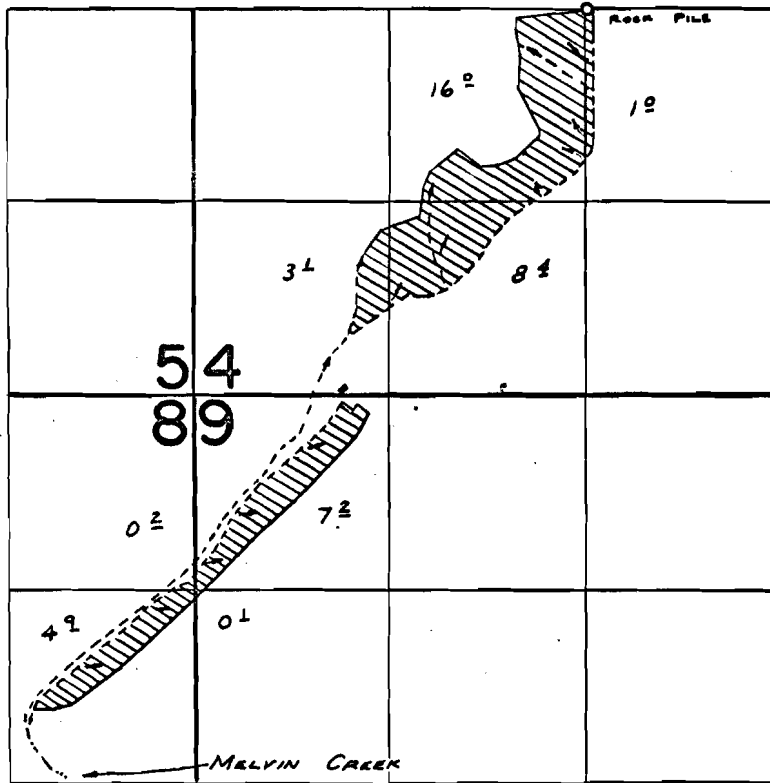

T.16 S.R.9E.W.M.

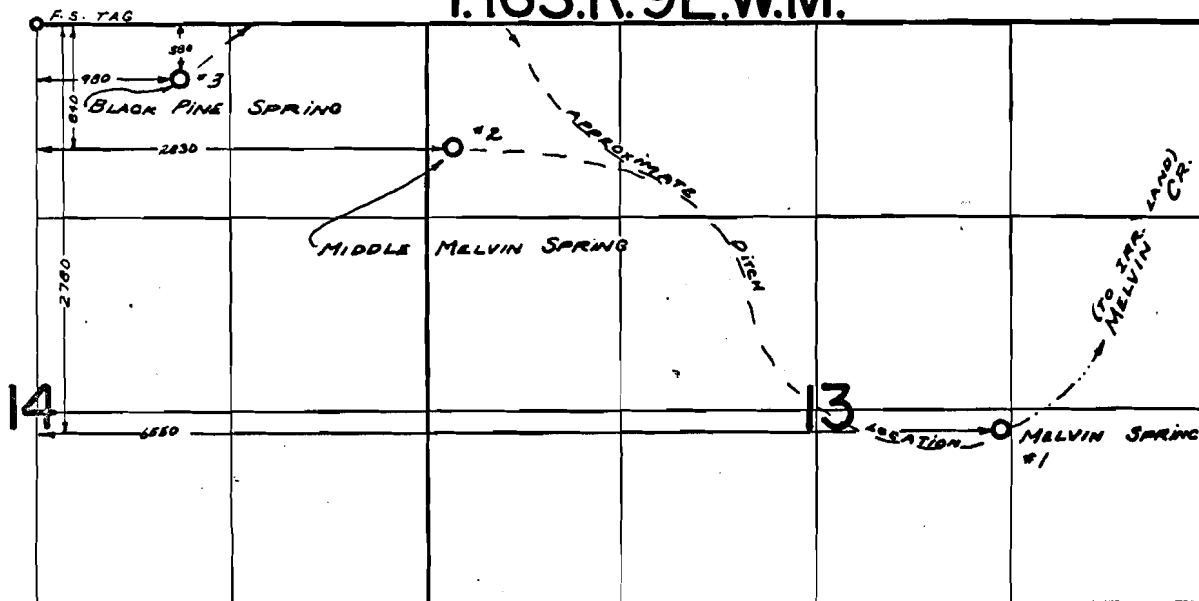

FINAL PROOF SURVEY
UNDER

Application No. 33051 Permit No. 26142
IN NAME OF

STEPHEN EBERLY THOMPSON JR.

Surveyed Oct. 25, 1968
Oct. 2, 1969, by D. Buell

p#26142
S.F.
1968
1969