


T. 32 & 33 S. R. 6 & 7 W. W. M.

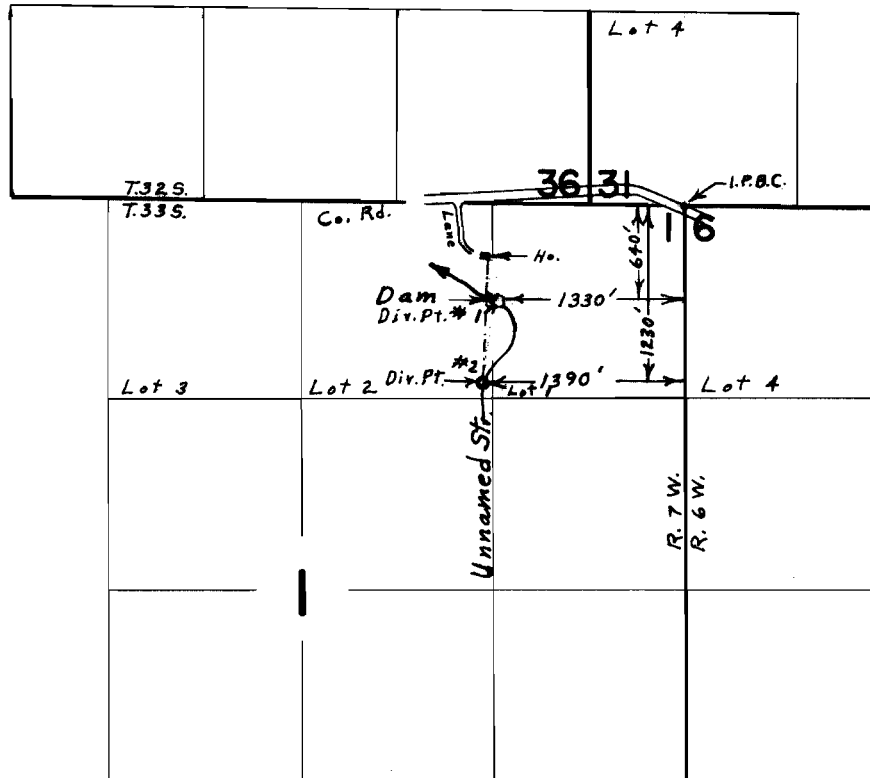

FINAL PROOF SURVEY
UNDER

Application No. 42552 Permit No. 31802
IN NAME OF

BESSIE R. DAY

Surveyed Aug. 22, 1972
May 2, 1969, by L. E. Gould