


T. 30 S. R. 5 W. W. M.

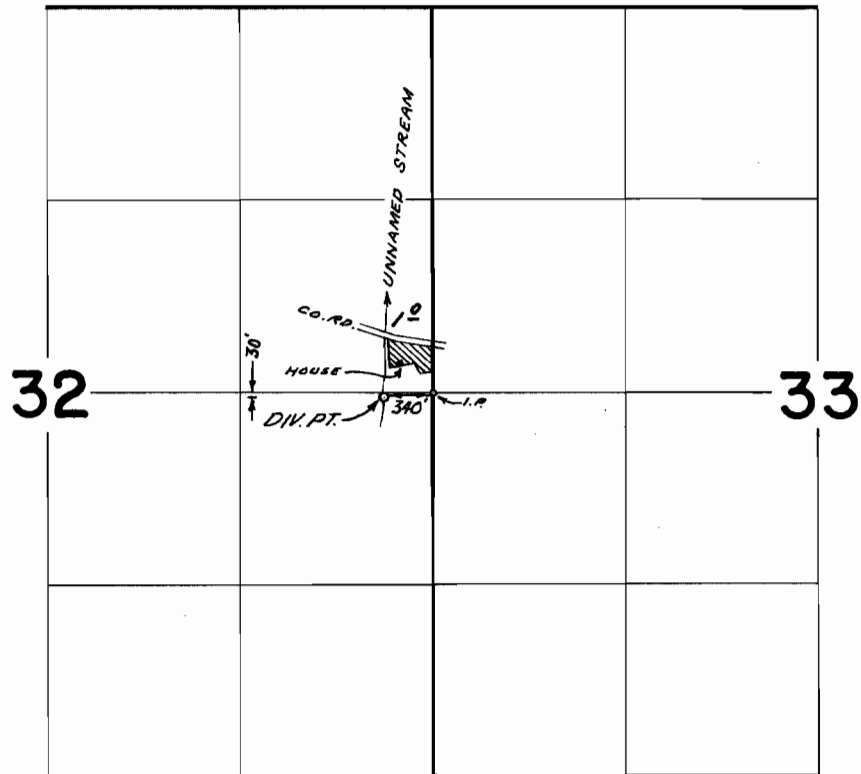

FINAL PROOF SURVEY
UNDER

Application No. 44645 Permit No. 33397
IN NAME OF

WILKINS C. AND MABEL E. DAVIS

Surveyed JUN. 23 1969, by D. BUELL