


27413
38815

T.40&41S.R.4E.W.M.

Jenny Ck. Meas.

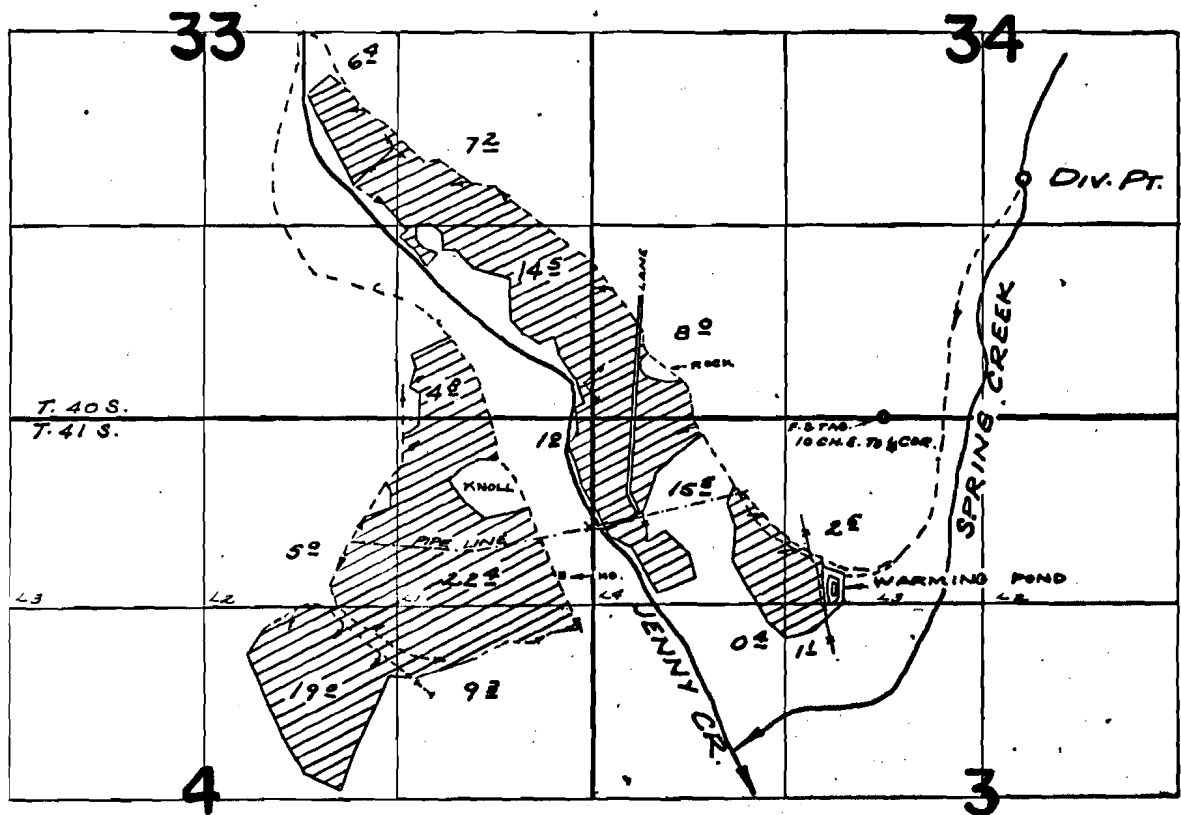

DIV. PT. LOC: 1620' N. & 260' E. FROM S. 1/4 COR. SEC. 34

FINAL PROOF SURVEY UNDER

Application No. 34954 Permit No. 27413
IN NAME OF

EVERETT WESLEY and/or VERNA ANN JOHNSON

Surveyed Oct. 12/16 1921, by R. MUDKIN