


G-4521

38818

14

T.41S.R.10E.W.M.


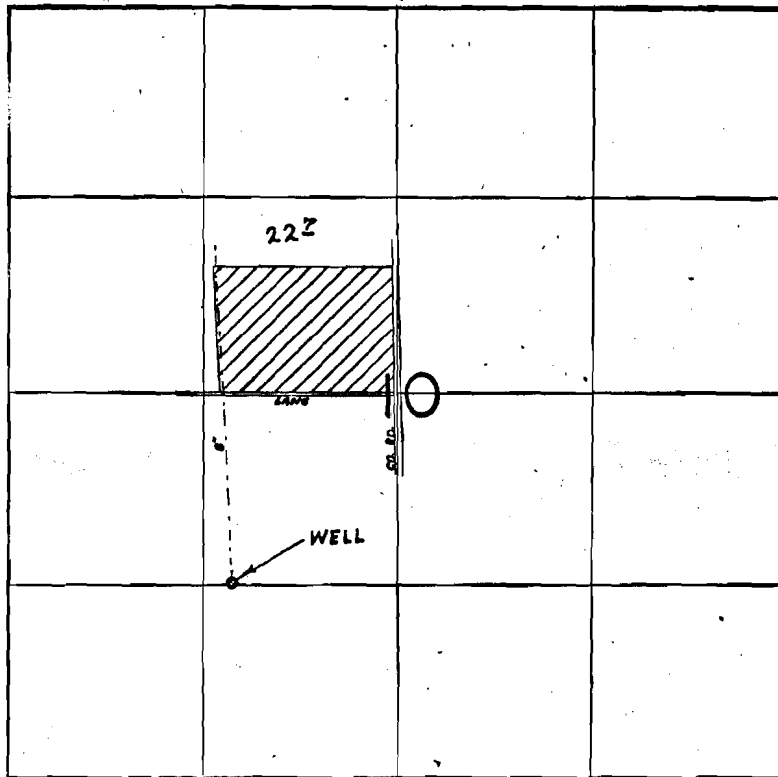

WELL LOC. N. 71° 39' E. 4332' FROM S1/4 COR. SEC. 9 (SEE PERMIT U-353)

FINAL PROOF SURVEY UNDER

Application No. G-4796.. Permit No. G-4521...
IN NAME OF

JOSEPH C. & WALTER W. FOTHERINGHAM

Surveyed SEP. 13, 1971, by R. MUCKEN.....