


T.38S.R.14E.W.M.

29966  
R-4484

3882  
3884

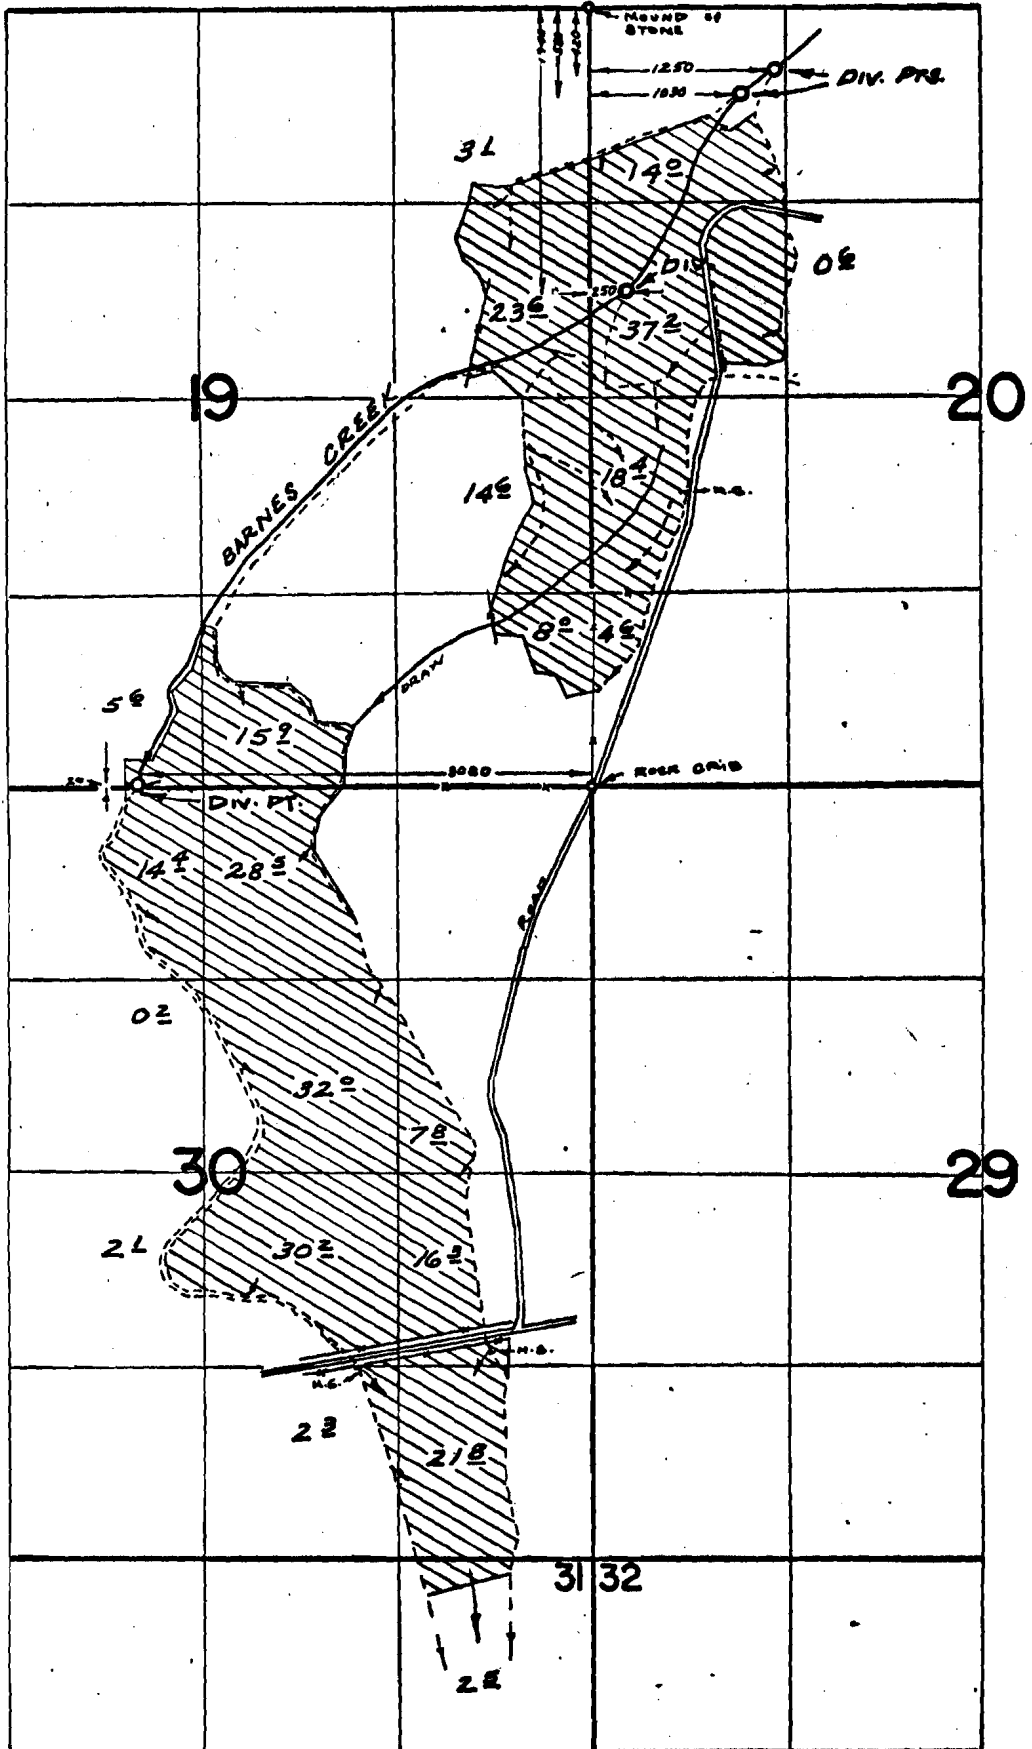

FINAL PROOF SURVEY

UNDER  
Application No. R-51180 Permit No. R-4484

IN NAME OF  
**HENRY C. & MARIAM W. GERBER**

Surveyed SEPT. 22, 1971, by R. MUCKEN