


T.38S.R.14E.W.M.

29966
R-4484

3882
3881

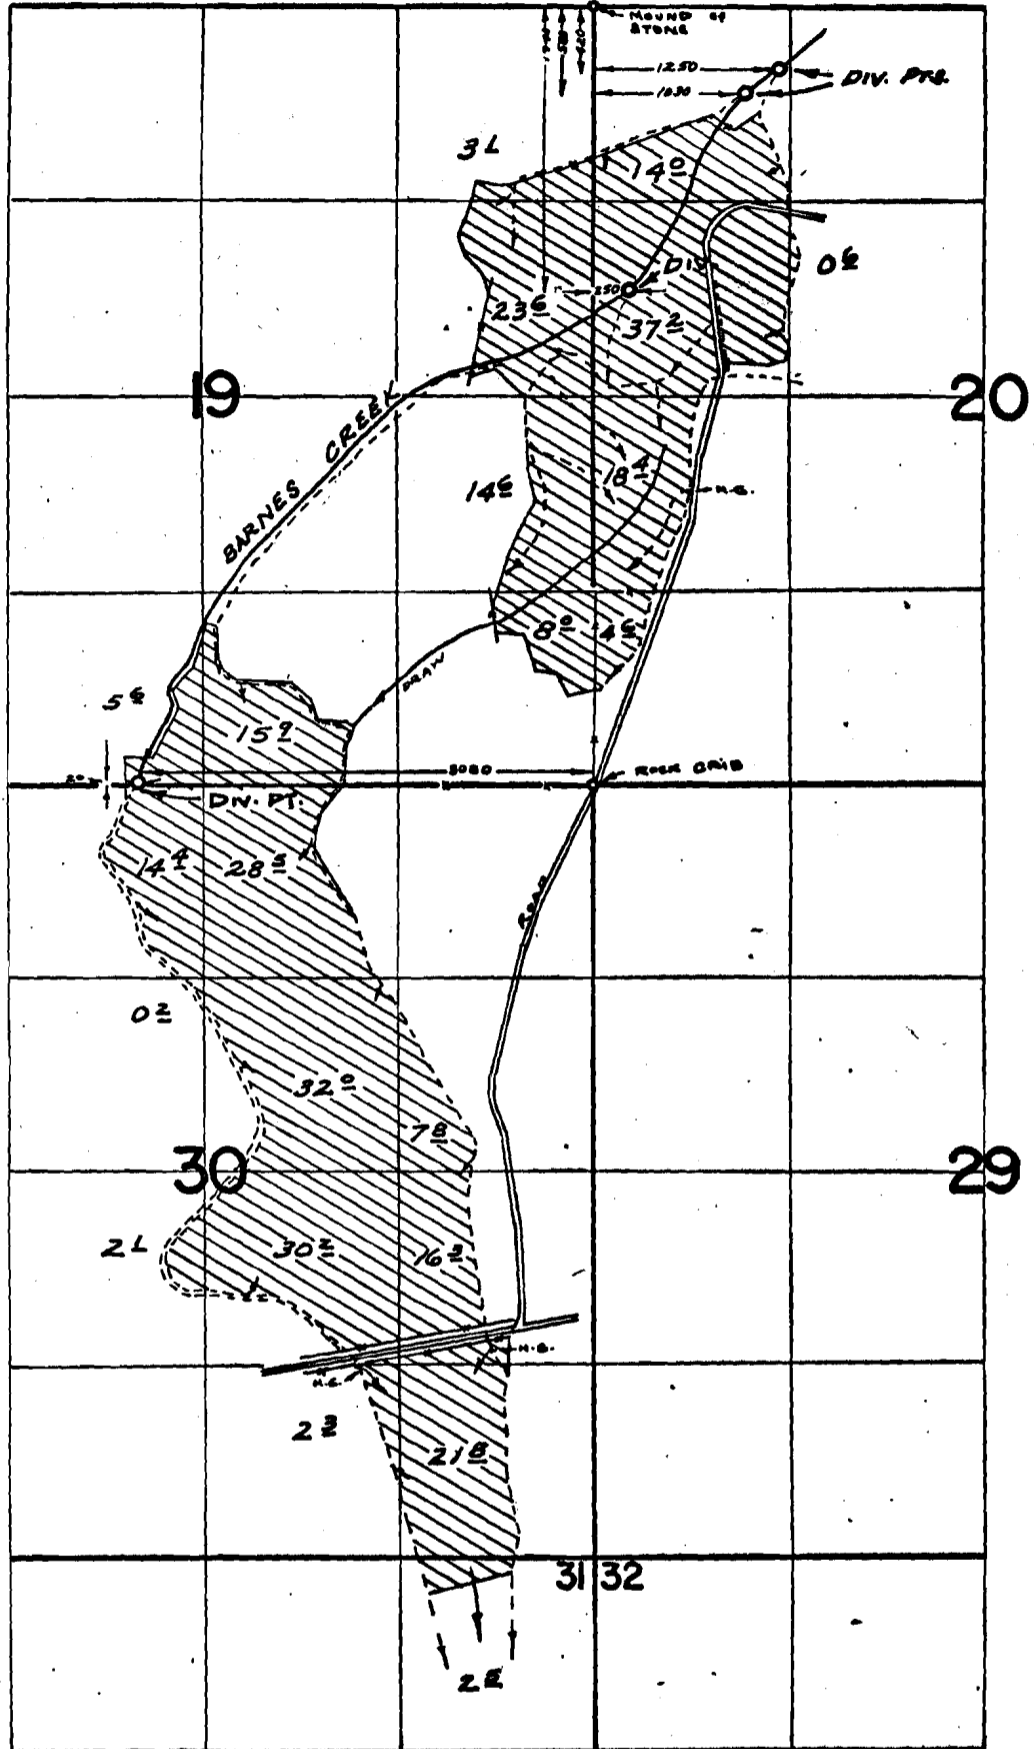

FINAL PROOF SURVEY

UNDER
R-51480

R-4484

Application No. ~~32479~~ Permit No. ~~29966~~

IN NAME OF

HENRY C. & MARIAM W. GERBER

Surveyed SEPT. 22, 1971, by R. MUGGEN