


T. 6 S. R. 2 W. W. M.

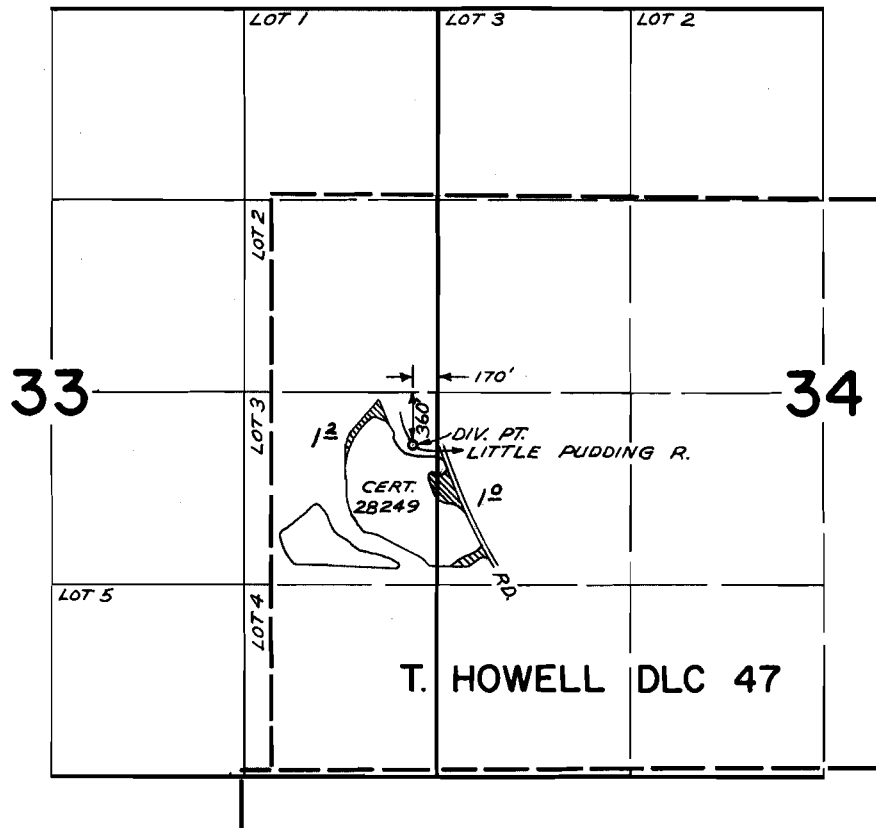

FINAL PROOF SURVEY  
UNDER

Application No. 40872 Permit No. 30469  
IN NAME OF

*LEROY L. & JEAN R. LAACK*

Surveyed APR. 7, 1971, by GREG BACA