


T. 8 S. R. 3 W. W. M.

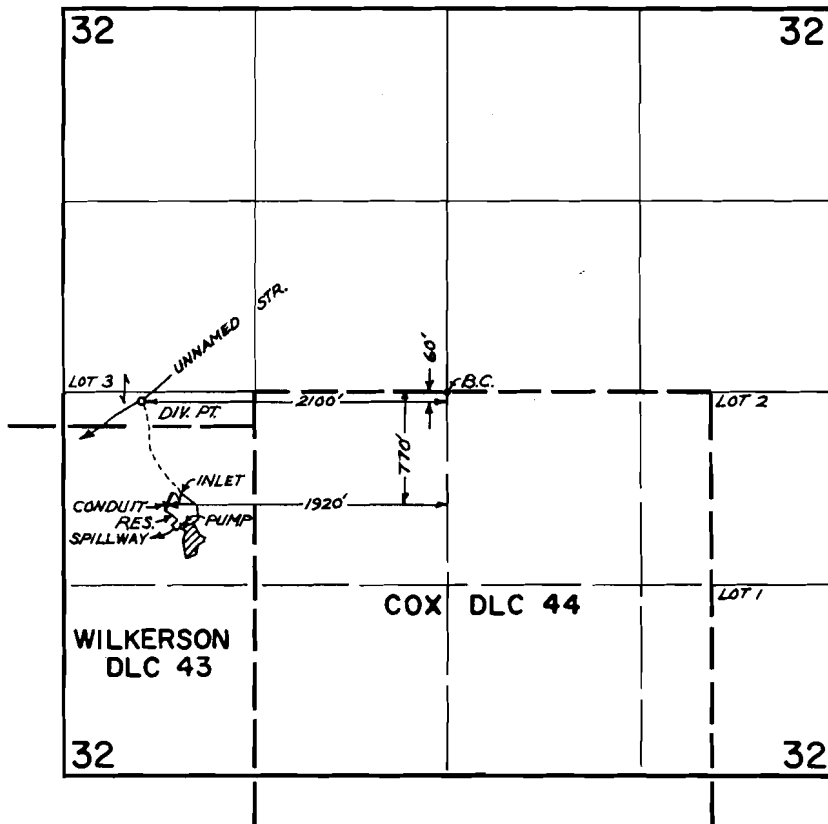

FINAL PROOF SURVEY
UNDER

Application No. R-41208 41209 Permit No. R-4653 30812
IN NAME OF

BEATRICE DRURY

Surveyed APR. 29 1971., by GREG. BACA