


38827 7

T.2N.R.23E.W.M.

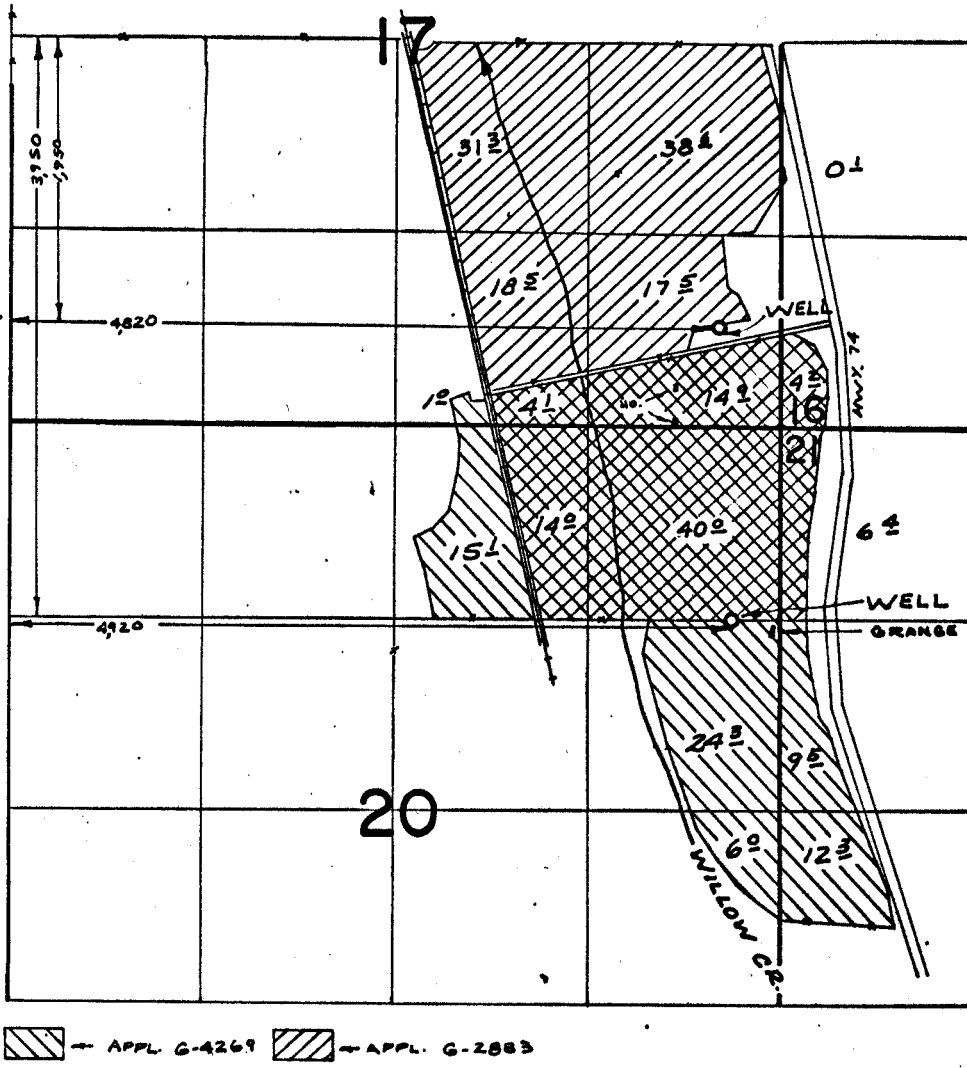

FINAL PROOF SURVEY UNDER

Application No. G-2883 Permit No. G-2702
~~G-4269~~ ~~G-4021~~

IN NAME OF

HYND BROTHERS CO.

Surveyed JUNE 28 1921, by R. MICKEN