


T.2S.R.24E.W.M.

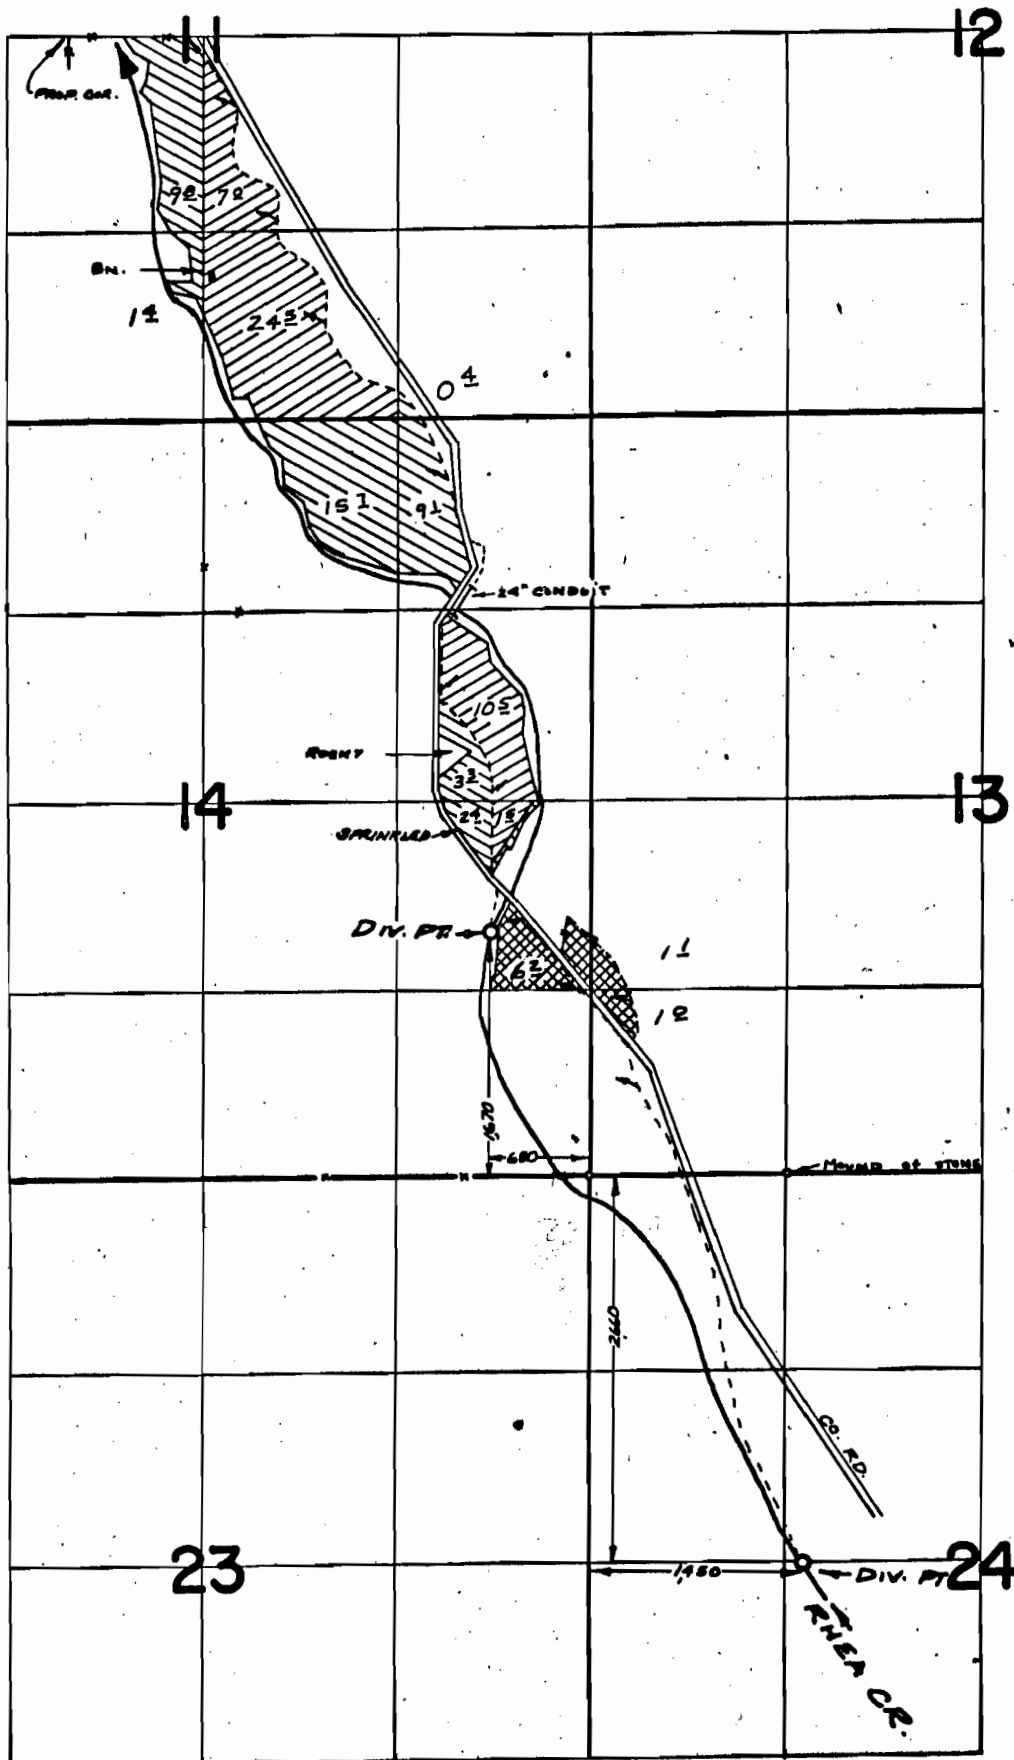

APPL. 39393  APPL. 39394 
 COVERED BY
 PRIOR RIGHTS
 CERT. 5860 & 512 

FINAL PROOF SURVEY

UNDER

Application No. 39393 39394 Permit No. 29361 29362

IN NAME OF

A. C. & BRYCE KEENE

Surveyed June 5, 1919, by R. MUCKEN