


T.2S.R.24E.W.M.

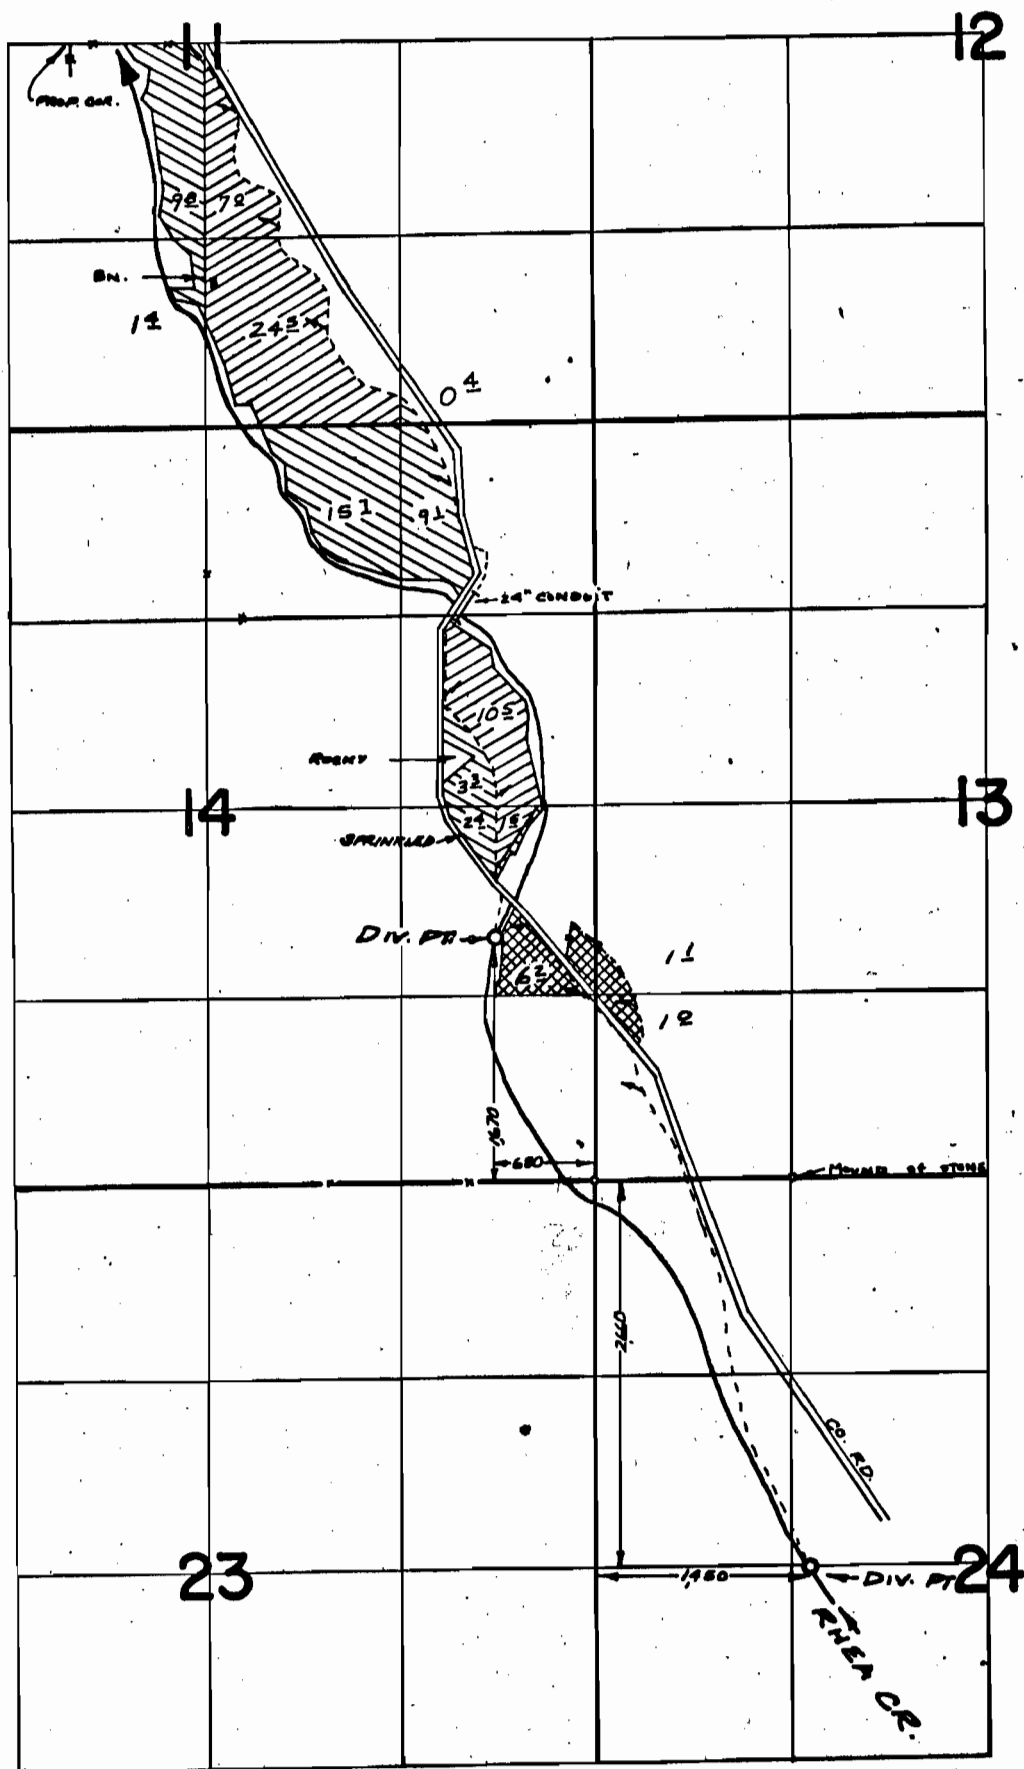

APPL. 39393
COVERED BY
PRIOR RIGHTS
CERT. 8860 & R12

APPL. 39394

FINAL PROOF SURVEY

UNDER

Application No. 39393 Permit No. 29361
39394 29362

IN NAME OF

A. C. & BRYCE KEENE

Surveyed JUN 5 1971, by R. MUCKEN