


T.I.N.R.IOW.W.M.

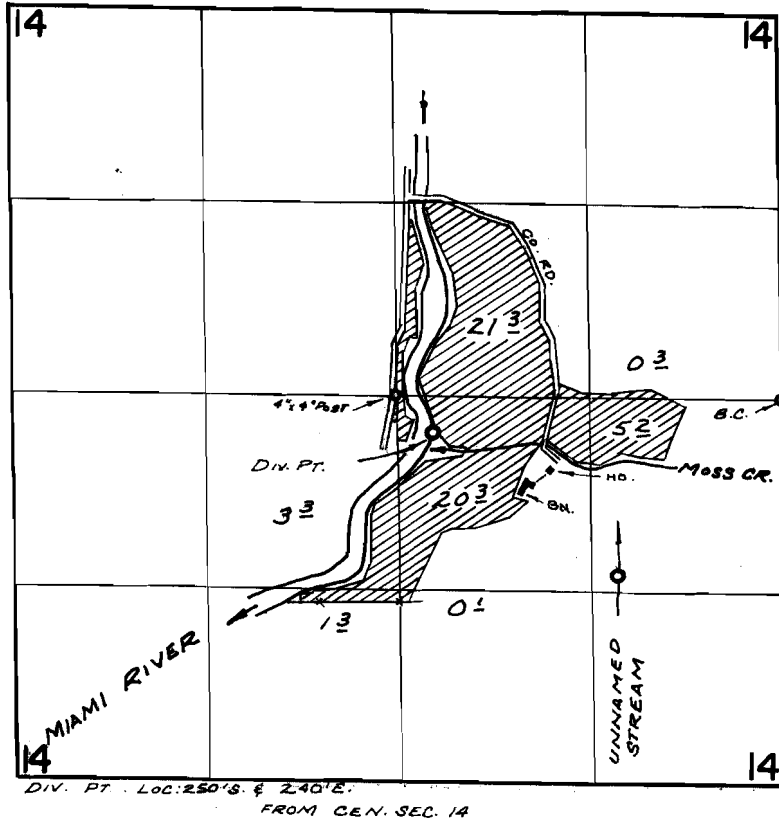

FINAL PROOF SURVEY UNDER

Application No. 40167... Permit No. 30203
IN NAME OF

ESTATE of JOHN FILOSI

Surveyed AUG. 4, 1971, by R. MUCKEN