


T. 1 S. R. 9 W. W. M.

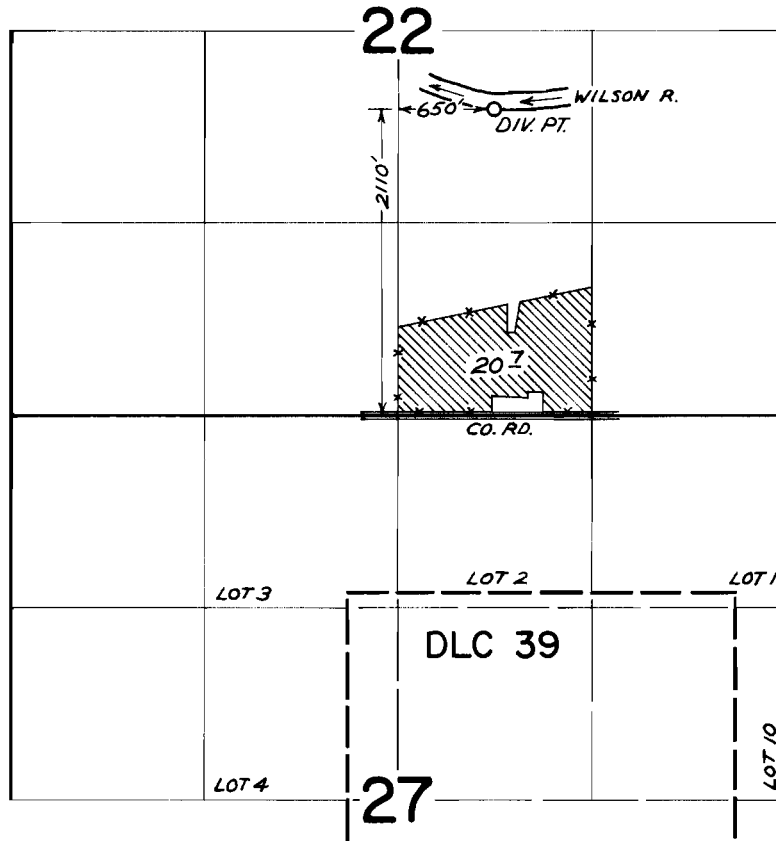

FINAL PROOF SURVEY UNDER

Application No. 41121..... Permit No. 30657.....
IN NAME OF

.....EDMUND H. DUYCK.....

Surveyed JUNE 7, 1971, by GREG BACA.....