


T. 1 S. R. 10 W. W. M.

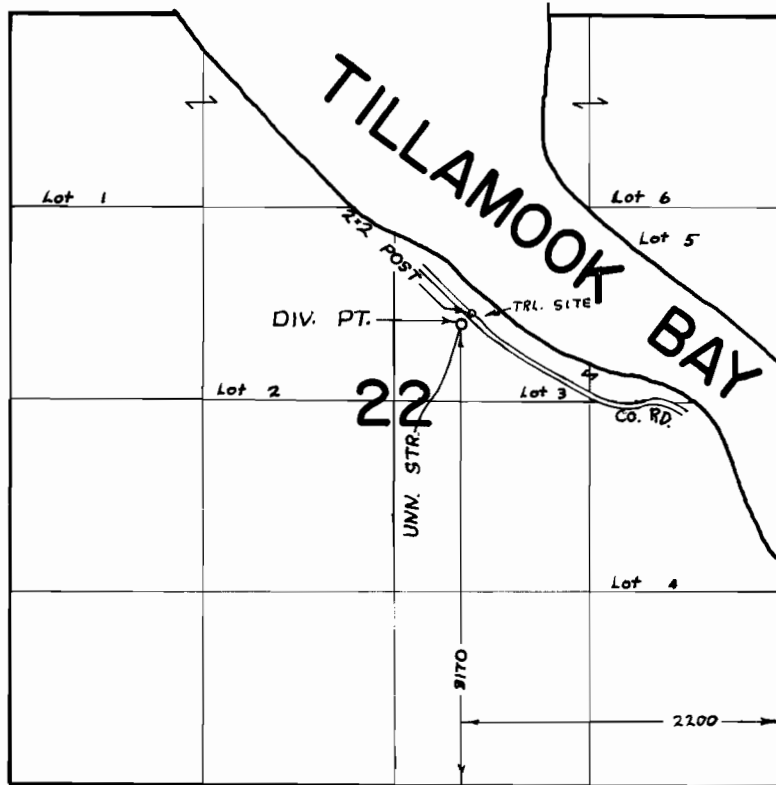

FINAL PROOF SURVEY
UNDER

Application No. 42147 Permit No. 31544
IN NAME OF

.....GEORGE K. SHABER.....

Surveyed AUG. 5., 1971., by R. MUCKEN.....