


G-2173

38840

7

T. 4 N. R. 34 E. W.M.

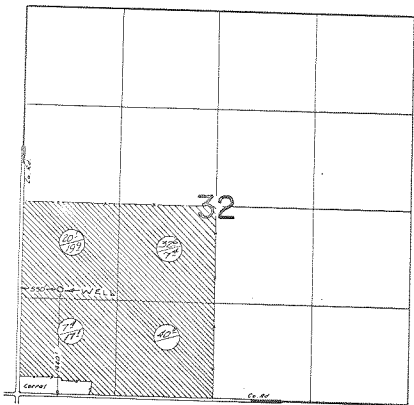

Primary  
 Supplemental

**FINAL PROOF SURVEY**  
UNDER

Application No. G-2354 Permit No. G-2173  
IN NAME OF

JOAN BARNETT RUGG

Surveyed Aug. 22 1921, by G. BACA