


T.6N.R.34E.W.M.

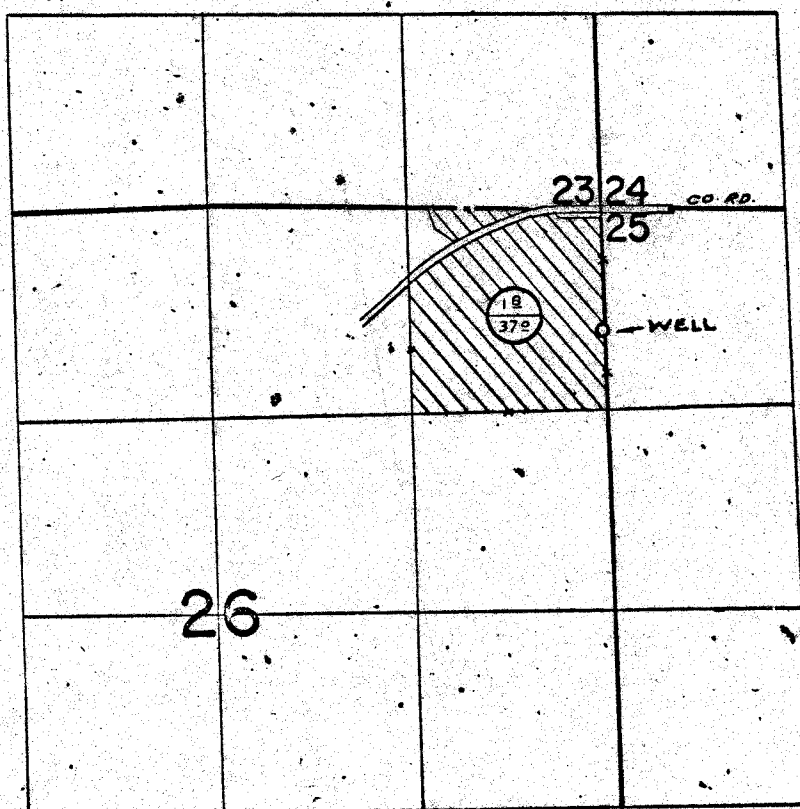

WELL LOC: 800'S. & 20'W. FROM N.E. COR. SEC. 26

FINAL PROOF SURVEY
UNDERApplication No. G-2586 Permit No. G-2437
IN NAME OFRALPH FRANKLINSurveyed AUG. 26, 1971, by G. BACA