


T. 1 S. R. 32 E. W.M.

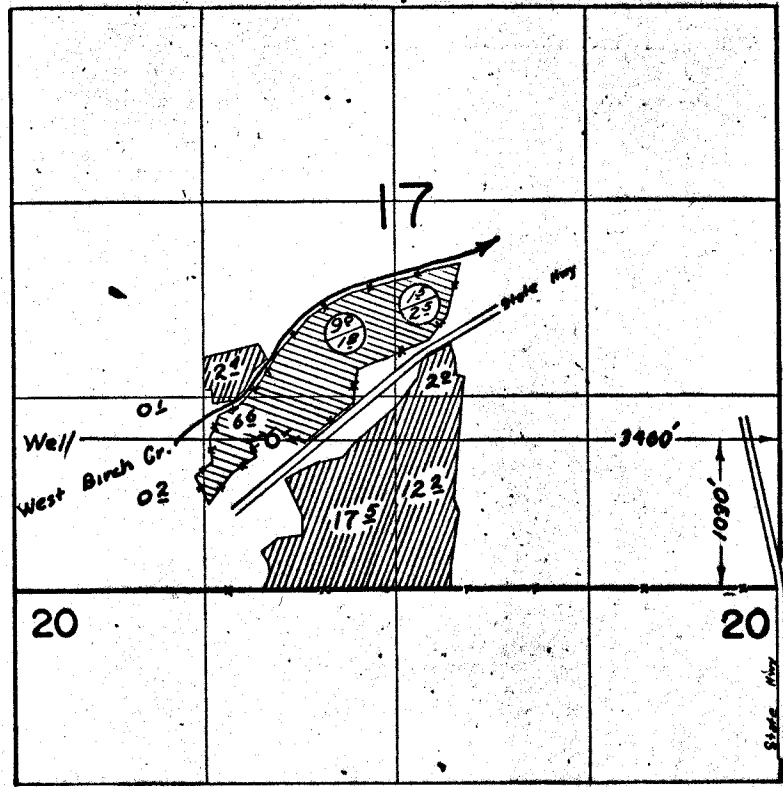

 PRIMARY
  SUPPLEMENTAL

 SUPPLEMENTAL
 PRIMARY

FINAL PROOF SURVEY UNDER

Application No. G-2741.. Permit No. G-2548.
IN NAME OF

RALPH J. HUTCHISON

Surveyed JUNE 29, 1971., by G. BACA.....