


# T. 1 N. R. 32 E. W. M.

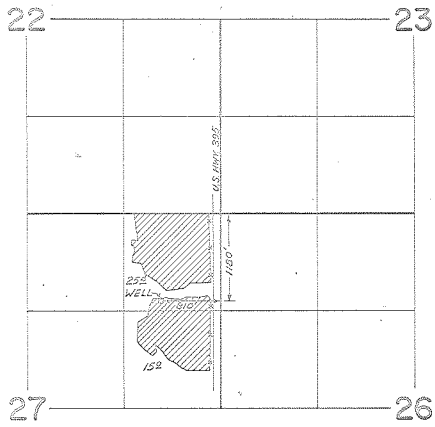

## FINAL PROOF SURVEY UNDER

Application No. G-2871... Permit No. G-2622...  
IN NAME OF

WILLIAM G. JINKINS

Surveyed JULY 1, 1971, by GREG. BACA.....