


G-2809
38846

T. 2 N. R. 27 E. W.M.

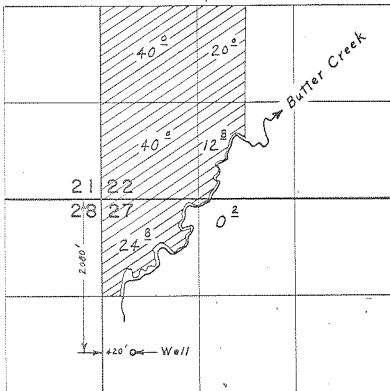

FINAL PROOF SURVEY
UNDER

Application No. G-3019. Permit No. G-2809.
IN NAME OF

MICHAEL JOHN KILKENNY

Surveyed Nov. 3, 1971, by L. E. Gould.