


G-35587
38847

T. 2 N. R. 27 E. W. M.

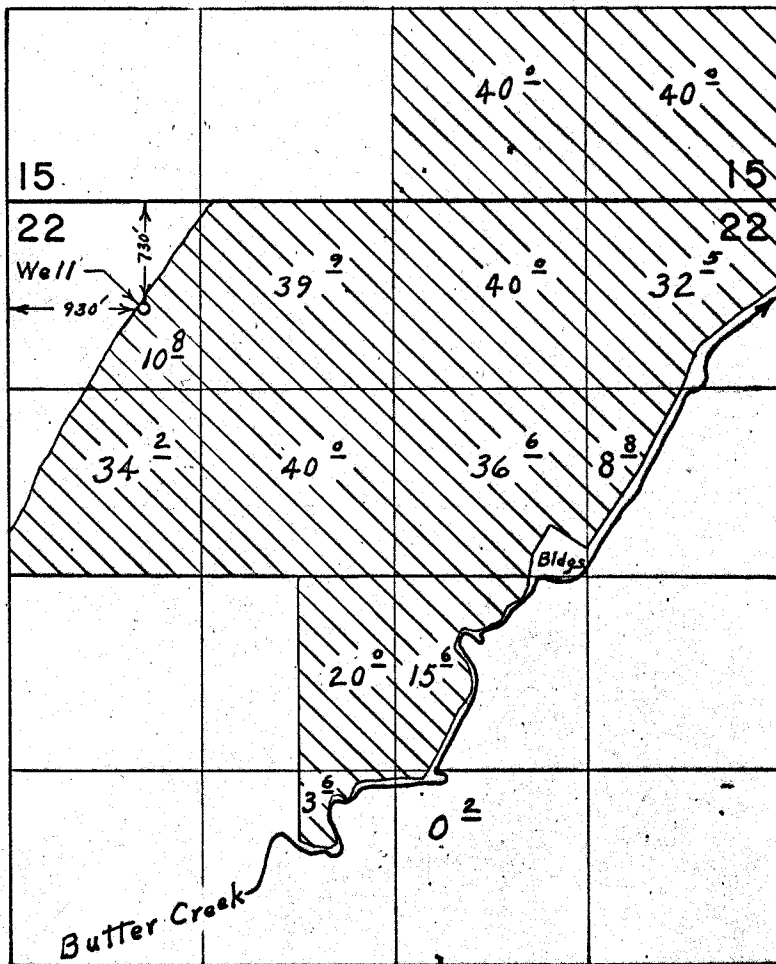

Well Permit
G-2809

FINAL PROOF SURVEY
UNDER

Application No. G-3772 Permit No. G-3558
IN NAME OF

MICHAEL JOHN KILKENNY

Surveyed Nov. 3, 1971, by L. E. Gould.