


G-2872
38848

T.6N.R.34E.W.M.

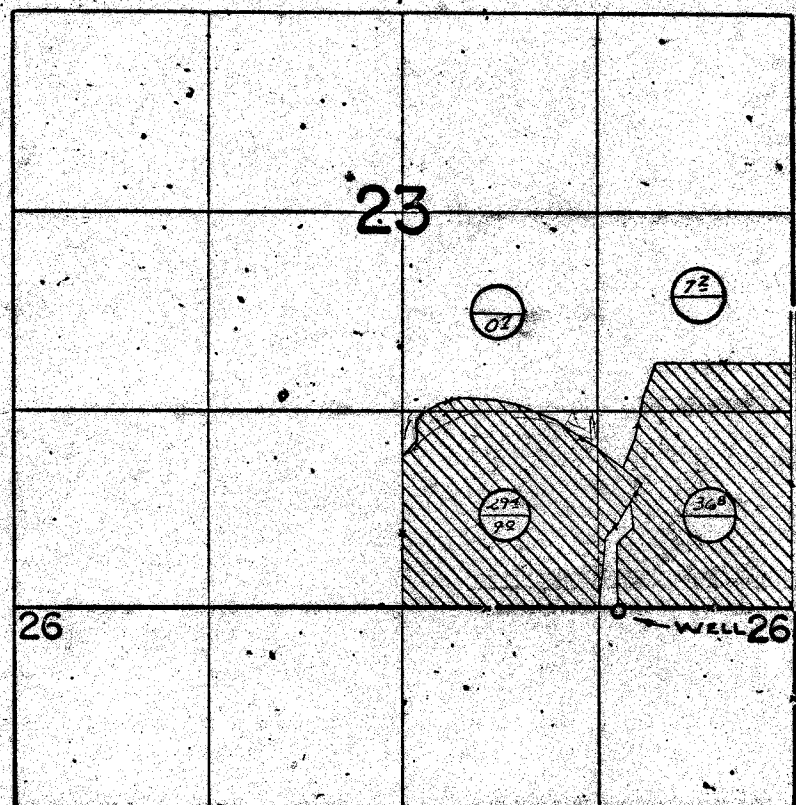

— PRIMARY

— SUPPLEMENTAL

WELL LOC: 20'S. & 1200' W. FROM SE. COR. SEC. 23

FINAL PROOF SURVEY
UNDER

Application No. G-3052 Permit No. G-2872
IN NAME OF
ESTATE OF
ERNEST MULLER

Surveyed AUG. 26, 1971, by G. BACA