


G-3000
38849 7

T 4 N. R. 28 E. W. M.

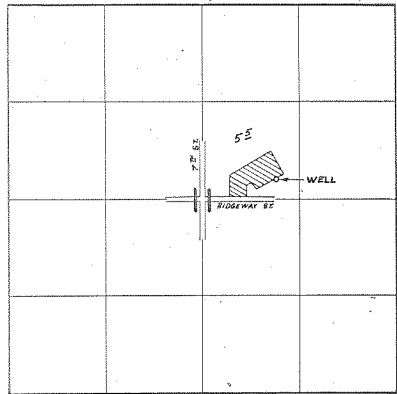

WELL LOC. 270' N & 1020' E FROM CENTER SEC. 11

FINAL PROOF SURVEY UNDER

Application No. G-3211... Permit No. G-3000.
IN NAME OF

AL H. & MABEL J. FOWLER.....

Surveyed AUG. 25. 1971., by L. E. GOULD...

178
1770